


1 LOCATION OF WATER WELL: Fraction Section Number Township Number Range Number
 County: Sheridan C $\frac{1}{4}$ NE $\frac{1}{4}$ NE $\frac{1}{4}$ 32 T 8 S R 29 **FW**

Distance and direction from nearest town or city street address of well if located within city?
2 Miles South, 1 Mile East, 1 Mile North of Seguin, Ks.

2 WATER WELL OWNER: Harold Koster Pfiefer Oil
 RR#, St. Address, Box # : Rt. 2 St. Peter Rd. Board of Agriculture, Division of Water Resources
 City, State, ZIP Code : Hoxie, Ks. 67740 Morland, Ks. 67650 Application Number: 960276

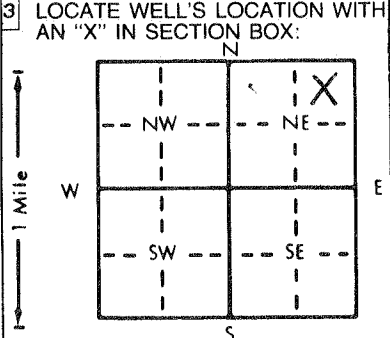

4 DEPTH OF COMPLETED WELL... 153... ft. ELEVATION: ft.
 Depth(s) Groundwater Encountered 1. ft. 2. ft. 3. ft.
 WELL'S STATIC WATER LEVEL 85... ft. below land surface measured on mo/day/yr ft.
 Pump test data: Well water was ft. after hours pumping gpm
 Est. Yield gpm: Well water was ft. after hours pumping gpm
 Bore Hole Diameter 8... in. to 153... ft., and in. to ft.
 WELL WATER TO BE USED AS: 5 Public water supply 8 Air conditioning 11 Injection well
 1 Domestic 3 Feedlot 6 Oil field water supply 9 Dewatering 12 Other (Specify below)
 2 Irrigation 4 Industrial 7 Lawn and garden only 10 Monitoring well
 Was a chemical/bacteriological sample submitted to Department? Yes.....No... X.....; If yes, mo/day/yr sample was submitted
 Water Well Disinfected? Yes No X.....

5 TYPE OF BLANK CASING USED: 5 Wrought iron 8 Concrete tile CASING JOINTS: Glued .. X .. Clamped
 1 Steel 3 RMP (SR) 6 Asbestos-Cement 9 Other (specify below) Welded
 2 PVC 4 ABS 7 Fiberglass Threaded
 Blank casing diameter ... 4.5... in. to ... 113... ft., Dia in. to ft., Dia in. to ft.
 Casing height above land surface 18... in., weight 2.38... lbs./ft. Wall thickness or gauge No. 248...
 TYPE OF SCREEN OR PERFORATION MATERIAL: 7 PVC 10 Asbestos-cement
 1 Steel 3 Stainless steel 5 Fiberglass 8 RMP (SR) 11 Other (specify)
 2 Brass 4 Galvanized steel 6 Concrete tile 9 ABS 12 None used (open hole)
 SCREEN OR PERFORATION OPENINGS ARE: 5 Gauzed wrapped 8 Saw cut 11 None (open hole)
 1 Continuous slot 3 Mill slot 6 Wire wrapped 9 Drilled holes
 2 Louvered shutter 4 Key punched 7 Torch cut 10 Other (specify)
 SCREEN-PERFORATED INTERVALS: From 113... ft. to 153... ft., From ft. to ft.
 From ft. to ft., From ft. to ft.
 GRAVEL PACK INTERVALS: From 20... ft. to 153... ft., From ft. to ft.
 From ft. to ft., From ft. to ft.

6 GROUT MATERIAL: 1 Neat cement 2 Cement grout 3 Bentonite 4 Other
 Grout Intervals: From ... 0... ft. to ... 20... ft., From ft. to ft., From ft. to ft.
 What is the nearest source of possible contamination:
 1 Septic tank 4 Lateral lines 7 Pit privy 10 Livestock pens 14 Abandoned water well
 2 Sewer lines 5 Cess pool 8 Sewage lagoon 11 Fuel storage 15 Oil well/Gas well
 3 Watertight sewer lines 6 Seepage pit 9 Feedyard 12 Fertilizer storage 16 Other (specify below)
 13 Insecticide storage
 Direction from well? NW How many feet? 150'

FROM	TO	LITHOLOGIC LOG	FROM	TO	PLUGGING INTERVALS
0	2	surface	122	130	fine med sand
2	8	fine sand	130	138	clay w/ sand stks
8	9	caliche	138	145	cemented sand w/ sand stks
9	13	clay	145	153	fine med sand
13	24	sand	153		shale
24	30	sandy clay caliche & sand stk			
30	52	fine med sand w/ clay & caliche			
52	58	sandy clay caliche w/ sand stks			
58	66	fine med sand w/ clay			
66	84	sandy clay w/ sand stks			
84	93	fine med sand w/ clay stks			
93	99	caliche w/ sand stks			
99	110	fine med sand			
110	114	cemented sand clay & sand stks			
114	122	cemented sand			

7 CONTRACTOR'S OR LANDOWNER'S CERTIFICATION: This water well was (1) constructed, (2) reconstructed, or (3) plugged under my jurisdiction and was completed on (mo/day/year) 8-26-96 and this record is true to the best of my knowledge and belief. Kansas Water Well Contractor's License No. 554 This Water Well Record was completed on (mo/day/yr) 8-27-96 under the business name of Woofter Pump & Well, Inc. by (signature) July C. Woofter

INSTRUCTIONS: Use typewriter or ball point pen. PLEASE PRESS FIRMLY and PRINT clearly. Please fill in blanks, underline or circle the correct answers. Send top three copies to Kansas Department of Health and Environment, Bureau of Water, Topeka, Kansas 66620-0001. Telephone: 913-296-5545. Send one to WATER WELL OWNER and retain one for your records.