


1 LOCATION OF WATER WELL: County: Sheridan Fraction: SE 1/4 NW 1/4 NW 1/4 Section Number: 2 Township Number: T 8 S Range Number: R 29 E

Distance and direction from nearest town or city street address of well if located within city?

2 WATER WELL OWNER: Murray Sloan
 RR#, St. Address, Box # : 21 Madole Road Board of Agriculture, Division of Water Resources
 City, State, ZIP Code : Edgewood, NM 87015 Application Number:

3 LOCATE WELL'S LOCATION WITH AN "X" IN SECTION BOX:

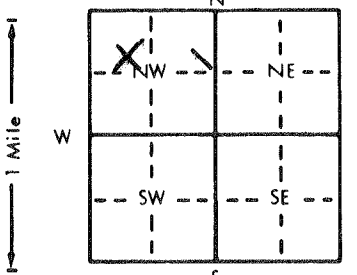

4 DEPTH OF COMPLETED WELL: 245 ft. ELEVATION: _____ ft.
 Depth(s) Groundwater Encountered 1. _____ ft. 2. _____ ft. 3. _____ ft.
 WELL'S STATIC WATER LEVEL: 183 ft. below land surface measured on mo/day/yr _____ ft.
 Pump test data: Well water was _____ ft. after _____ hours pumping _____ gpm
 Est. Yield _____ gpm: Well water was _____ ft. after _____ hours pumping _____ gpm
 Bore Hole Diameter: 8 in. to 245 ft., and _____ in. to _____ ft.
 WELL WATER TO BE USED AS:
 1 Domestic 3 Feedlot 6 Oil field water supply 9 Dewatering 11 Injection well
 2 Irrigation 4 Industrial 7 Lawn and garden only 10 Monitoring well 12 Other (Specify below)
 Was a chemical/bacteriological sample submitted to Department? Yes _____ No X; If yes, mo/day/yr sample was sub-
 mitted Water Well Disinfected? Yes _____ No X

5 TYPE OF BLANK CASING USED:
 1 Steel 3 RMP (SR) 5 Wrought iron 8 Concrete tile CASING JOINTS: Glued X Clamped _____
 2 PVC 4 ABS 6 Asbestos-Cement 9 Other (specify below) Welded _____
 7 Fiberglass Threaded _____
 Blank casing diameter _____ in. to 4.5 in. to 205 ft., Dia _____ in. to _____ ft., Dia _____ in. to _____ ft.
 Casing height above land surface: 18 in., weight 2.38 lbs./ft. Wall thickness or gauge No. 248
 TYPE OF SCREEN OR PERFORATION MATERIAL:
 1 Steel 3 Stainless steel 5 Fiberglass 7 PVC 10 Asbestos-cement
 2 Brass 4 Galvanized steel 6 Concrete tile 8 RMP (SR) 11 Other (specify) _____
 12 None used (open hole)
 SCREEN OR PERFORATION OPENINGS ARE:
 1 Continuous slot 3 Mill slot 5 Gauzed wrapped 8 Saw cut 11 None (open hole)
 2 Louvered shutter 4 Key punched 6 Wire wrapped 9 Drilled holes
 7 Torch cut 10 Other (specify) _____
 SCREEN-PERFORATED INTERVALS: From _____ ft. to 205 ft. to 245 ft., From _____ ft. to _____ ft. to _____ ft.
 GRAVEL PACK INTERVALS: From _____ ft. to 20 ft. to 245 ft., From _____ ft. to _____ ft. to _____ ft.

6 GROUT MATERIAL: 1 Neat cement 2 Cement grout 3 Bentonite 4 Other _____
 Grout Intervals: From 0 ft. to 20 ft., From _____ ft. to _____ ft., From _____ ft. to _____ ft.
 What is the nearest source of possible contamination: None
 1 Septic tank 4 Lateral lines 7 Pit privy 10 Livestock pens 14 Abandoned water well
 2 Sewer lines 5 Cess pool 8 Sewage lagoon 11 Fuel storage 15 Oil well/Gas well
 3 Watertight sewer lines 6 Seepage pit 9 Feedyard 12 Fertilizer storage 16 Other (specify below)
 13 Insecticide storage
 Direction from well? _____ How many feet? _____

FROM	TO	LITHOLOGIC LOG	FROM	TO	PLUGGING INTERVALS
0	2	Surface	153	159	Med sand
2	21	Loess	159	161	Clay
21	58	Clay & caliche stks, silty clay & sand stks	161	171	Med sand
			171	183	Caliche & cemented sand & sand stks
58	60	Sand	183	187	Sand
60	66	Sandy clay	187	195	Caliche, clay & sand stks
66	70	Sand	195	200	Tight sand
70	90	Clay, caliche, & sand stks	200	205	Clay & caliche
90	93	Caliche	205	215	Semi-tight sand clay & caliche stks
93	99	Clay & sand stks	215	222	Med sand & gravel
99	115	Med sand	222	226	Caliche
115	123	Clay & caliche lenses	226	238	Med sand & gravel
123	139	clay & caliche	238	239	Caliche
139	150	Tight sand & caliche & clay lenses	239	245	Med sand & caliche layers
150	153	Clay			

7 CONTRACTOR'S OR LANDOWNER'S CERTIFICATION: This water well was (1) constructed, (2) reconstructed, or (3) plugged under my jurisdiction and was completed on (mo/day/year) 8-8-97 and this record is true to the best of my knowledge and belief. Kansas Water Well Contractor's License No. 554 This Water Well Record was completed on (mo/day/yr) 8-21-97 under the business name of Woofter Pump & Well, Inc. by (signature) [Signature]