WATER WELL RECORD Form WWC-5 KSA 82a-1212

1 LOCATION OF WATER WELL: County: Sheridan | Fraction: SE ¼ NE ¼ NE ¼ | Section Number: 6 | Township Number: T 8 S | Range Number: R 29 E (W)

Distance and direction from nearest town or city street address of well if located within city?
2 Miles North 8 West of Hoxie, Kansas

2 WATER WELL OWNER: Gerald Hill
RR#, St. Address, Box # : Box 621
City, State, ZIP Code : Hoxie, Ks. 67740
Board of Agriculture, Division of Water Resource
Application Number: 16344

3 LOCATE WELL'S LOCATION WITH AN "X" IN SECTION BOX:

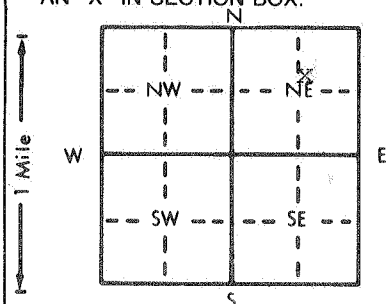

4 DEPTH OF COMPLETED WELL 273 ft. ELEVATION:
Depth(s) Groundwater Encountered 1. ft. 2. ft. 3. ft.
WELL'S STATIC WATER LEVEL 173 ft. below land surface measured on mo/day/yr 2-23-89
Pump test data: Well water was ft. after hours pumping gpm
Est. Yield 900 gpm: Well water was ft. after hours pumping gpm
Bore Hole Diameter 8 in. to 273 ft., and in. to ft.
WELL WATER TO BE USED AS: 1 Domestic 2 Irrigation 3 Feedlot 4 Industrial 5 Public water supply 6 Oil field water supply 7 Lawn and garden only 8 Air conditioning 9 Dewatering 10 Monitoring well 11 Injection well 12 Other (Specify below)
Was a chemical/bacteriological sample submitted to Department? Yes No X; If yes, mo/day/yr sample was submitted
Water Well Disinfected? Yes No X

5 TYPE OF BLANK CASING USED: 1 Steel 2 PVC 3 RMP (SR) 4 ABS 5 Wrought iron 6 Asbestos-Cement 7 Fiberglass 8 Concrete tile 9 Other (specify below)
CASING JOINTS: Glued Clamped Welded X Threaded
Blank casing diameter 16 in. to 193 ft., Dia in. to ft., Dia in. to ft.
Casing height above land surface 12 in., weight 36.91 lbs./ft. Wall thickness or gauge No. .219

TYPE OF SCREEN OR PERFORATION MATERIAL: 1 Steel 2 Brass 3 Stainless steel 4 Galvanized steel 5 Fiberglass 6 Concrete tile 7 PVC 8 RMP (SR) 9 ABS 10 Asbestos-cement 11 Other (specify) 12 None used (open hole)
SCREEN OR PERFORATION OPENINGS ARE: 1 Continuous slot 2 Louvered shutter 3 Mill slot 4 Key punched 5 Gauzed wrapped 6 Wire wrapped 7 Torch cut 8 Saw cut 9 Drilled holes 10 Other (specify) 11 None (open hole)
SCREEN-PERFORATED INTERVALS: From 193 ft. to 273 ft., From ft. to ft.
From ft. to ft., From ft. to ft.
GRAVEL PACK INTERVALS: From 20 ft. to 273 ft., From ft. to ft.
From ft. to ft., From ft. to ft.

6 GROUT MATERIAL: 1 Neat cement 2 Cement grout 3 Bentonite 4 Other
Grout Intervals: From 0 ft. to 20 ft., From ft. to ft., From ft. to ft.
What is the nearest source of possible contamination:
1 Septic tank 2 Sewer lines 3 Watertight sewer lines 4 Lateral lines 5 Cess pool 6 Seepage pit 7 Pit privy 8 Sewage lagoon 9 Feedyard 10 Livestock pens 11 Fuel storage 12 Fertilizer storage 13 Insecticide storage 14 Abandoned water well 15 Oil well/Gas well 16 Other (specify below)
Direction from well? West How many feet? 2640

FROM	TO	LITHOLOGIC LOG
0	3	Surface
3	58	Clay
58	64	Med sand
64	74	Clay
74	79	Caliche
79	83	Med sand
83	86	Caliche & cemented sand
86	88	Clay
88	96	Med sand
96	101	Clay
101	107	Caliche
107	113	Clay
113	121	Med sand
121	123	Caliche
123	126	Med sand
126	134	Sandy clay
134	141	Med sand
141	148	Caliche
148	152	Clay
152	153	Caliche
153	164	Med sand
164	165	Caliche
165	172	Med sand
172	173	Clay
173	176	Caliche
176	177	Med sand
177	178	Caliche
178	184	Med sand
184	186	Caliche
186	187	Clay

PLUGGING INTERVALS
187 - 226 Caliche
226 - 228 Med sa
228 - 230 Clay
230 - 233 Caliche
233 - 237 Clay
237 - 239 Med sa
239 - 240 Clay
240 - 262 Med sa
262 - 270 Shale

7 ~~CONTRACTOR'S~~ OR LANDOWNER'S CERTIFICATION: This water well was (1) constructed, (2) reconstructed, or (3) plugged under my jurisdiction and was completed on (mo/day/year) 2-28-89 and this record is true to the best of my knowledge and belief. Kansas Water Well Contractor's License No. 394 This Water Well Record was completed on (mo/day/yr) 3-16-89
under the business name of Woofter Pump & Well by (signature) Walk Woof

INSTRUCTIONS: Use typewriter or ball point pen. *PLEASE PRESS FIRMLY* and *PRINT* clearly. Please fill in blanks, underline or circle the correct answers. Send top three copies to Kansas Department of Health and Environment, Bureau of Water Protection, Topeka, Kansas 66620-7320. Telephone: 913-296-5514. Send one to WATER WELL OWNER and retain one for your records.