

Verified by phone to, Mr. Corder 4-8-80  
 Dwight Brinkley

USE TYPEWRITER OR BALL POINT PEN-PRESS FIRMLY, PRINT CLEARLY.


WATER WELL RECORD  
 KSA 82a-1201b-121b

Kansas Department of Health and Environment-Division of Environment  
 (Water well Contractors)  
 Topeka, Kansas 66620

Please correct your copy of this from record



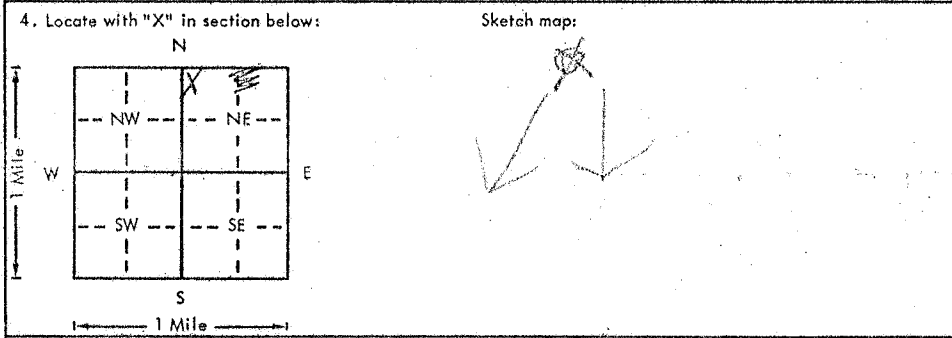

6. Bore hole dia. 2 1/2 in. Completion date 5-3-76  
 Well depth 261 ft.  
 7.  Cable tool  Rotary  Driven  Dug  
 Hollow rod  Jetted  Bored  Reverse rotary  
 8. User:  Domestic  Public supply  Industry  
 Irrigation  Air conditioning  Stock  
 Lawn  Oil field water  Other  
 9. Casing: Material Steel Height: Above or below  
 Threaded  Welded  Surface 18 in.  
 RMP  PVC  Weight 58.5 lbs./ft.  
 Dia. 4 in. to 261 ft. depth Wall Thickness: inches or  
 Dia. 4 in. to 261 ft. depth gage No. 7/8 in


| 5. Type and color of material | From       | To         |
|-------------------------------|------------|------------|
| <u>0-146 Top</u>              | <u>0</u>   | <u>146</u> |
| <u>Sand Clay</u>              | <u>146</u> | <u>161</u> |
| <u>Sand</u>                   | <u>161</u> | <u>164</u> |
| <u>Sandy Clay</u>             | <u>164</u> | <u>187</u> |
| <u>Sand + clay streaks</u>    | <u>187</u> | <u>211</u> |
| <u>Sand</u>                   | <u>211</u> | <u>219</u> |
| <u>Fine sand w/ clay</u>      | <u>219</u> | <u>227</u> |
| <u>Sandy Clay</u>             | <u>227</u> | <u>230</u> |
| <u>Fine sand w/ clay</u>      | <u>230</u> | <u>234</u> |
| <u>Sand</u>                   | <u>234</u> | <u>241</u> |
| <u>Thin stone</u>             | <u>244</u> | <u>245</u> |
| <u>Sand + gravel</u>          | <u>245</u> | <u>258</u> |
| <u>Sand</u>                   | <u>258</u> | <u>261</u> |
| <u>Gravel</u>                 | <u>261</u> | <u>263</u> |

10. Screen: Manufacturer's name Johns Manville  
 Type Slot Dia. 16 in  
 Slot/gauze 1/8 in Length 60  
 Set between 200 ft. and 261 ft.  
 Gravel pack?  Size range of material 20  
 11. Static water level: 146 ft. below land surface mo./day/yr. 1-1-76  
 12. Pumping level below land surfaces:  
500 ft. after 10 hrs. pumping 1000 g.p.m.  
211 ft. after 2 hrs. pumping 1000 g.p.m.  
 Estimated maximum yield 1000 g.p.m.  
 13. Water sample submitted: 1 Yes  No Date 5-3-76  
 14. Well head completion: 18 Pitless adapter 18 inches above grade  
 15. Well grouted? Yes  
 With:  Neat cement  Bentonite  Concrete  
 Depth: From 18 ft. to 20 ft.  
 16. Nearest source of possible contamination: Pool  
 ft. 20 Direction west Type Pool  
 Well disinfected upon completion?  Yes  No  
 17. Pump:  Not installed  
 Length of drop pipe 250 ft. capacity 150 g.p.m.  
 Type:  
 Submersible  Turbine  
 Jet  Reciprocating  
 Centrifugal  Other

18. Elevation:  
 Topography:  
 Hill  
 Slope  
 Upland  
 Valley

19. Remarks:  
 (Use a second sheet if needed)

20. Water well contractor's certification:  
 This well was drilled under my jurisdiction and this report is true to the best of my knowledge and belief.  
 Authorized representative

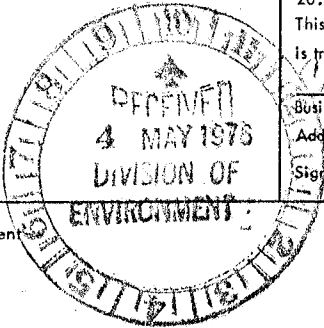

USE TYPEWRITER OR BALL POINT PEN-PRESS FIRMLY, PRINT CLEARLY.

WATER WELL RECORD  
KSA 82a-1201-1215

Kansas Department of Health and Environment-Division of Environment (Water well Contractors) Topeka, Kansas 66620

AAB

|   |  |                                |                                       |   |                               |                           |
|---|--|--------------------------------|---------------------------------------|---|-------------------------------|---------------------------|
| <input checked="" type="checkbox"/> Location of well:   |  | County: <u>Sherman</u>         | Fraction: <u>NE 1/4 NE 1/4 NE 1/4</u> | Section number: <u>8</u>  | Township number: <u>T 8 S</u> | Range number: <u>R 29</u> |
| <input checked="" type="checkbox"/> Distance and direction from nearest town or city: <u>Hoxie Ks 1 1/2 N - 5 1/2 West</u>                                      |  |                                | 3. Owner of well: <u>Darrel Allen</u> |   |                               |                           |
| Street address of well location if in city:   |  |                                | R.R. or street: <u>Selden Ks</u>      |   |                               |                           |
| City, state, zip code:  |  |                                | <u>Selden Ks</u>                      |   |                               |                           |
| 4. Locate with "X" in section below:  |  | Sketch map:                    |                                       | 6. Bore hole dia. <u>2 1/2</u> in. Completion date _____<br>Well depth _____ ft.  |                               |                           |
|   |  |                                |                                       | 7. <input checked="" type="checkbox"/> Cable tool <input checked="" type="checkbox"/> Rotary <input type="checkbox"/> Driven <input type="checkbox"/> Dug<br><input type="checkbox"/> Hollow rod <input type="checkbox"/> Jetted <input type="checkbox"/> Bored <input type="checkbox"/> Reverse rotary   |                               |                           |
| 5. Type and color of material   |  | From                           | To                                    | 8. Use: <input type="checkbox"/> Domestic <input type="checkbox"/> Public supply <input type="checkbox"/> Industry<br><input checked="" type="checkbox"/> Irrigation <input type="checkbox"/> Air conditioning <input type="checkbox"/> Stock<br><input type="checkbox"/> Lawn <input type="checkbox"/> Oil field water <input type="checkbox"/> Other  |                               |                           |
| <u>0 - 146 Top</u>  |  | <u>0</u>                       | <u>146</u>                            | 9. Casing: Material <u>galv</u> Height: Above or below<br>Threaded <input type="checkbox"/> Welded <input type="checkbox"/> Surface <u>1 1/2</u> in.<br>RMP <input type="checkbox"/> PVC <input type="checkbox"/> Weight <u>38.5</u> lbs./ft.<br>Dia. <u>1 1/2</u> in. to <u>2 1/2</u> ft. depth Wall Thickness: inches or<br>Dia. _____ in. to _____ ft. depth gage No. <u>7/8 in</u>  |                               |                           |
| <u>Sand Clay</u>  |  | <u>146</u>                     | <u>161</u>                            | 10. Screens: Manufacturer's name <u>Johys Mammel</u><br>Type <u>Slot</u> Dia. <u>1 1/2 in</u><br>Slot/gauze <u>1/8 in</u> Length <u>60</u><br>Set between <u>200</u> ft. and <u>261</u> ft.<br>_____ ft. and _____ ft.  |                               |                           |
| <u>Sand</u>   |  | <u>161</u>                     | <u>164</u>                            | Gravel pack? <u>Yes</u> Size range of material <u>1/4</u>   |                               |                           |
| <u>Sandy Clay</u>   |  | <u>164</u>                     | <u>187</u>                            | 11. Static water level: _____ mg./day/yr.<br><u>146</u> ft. below land surface Date <u>1-1-76</u>   |                               |                           |
| <u>Sand + Clay Stripes</u>  |  | <u>187</u>                     | <u>211</u>                            | 12. Pumping level below land surfaces:<br><u>250</u> ft. after <u>10</u> hrs. pumping <u>1000</u> g.p.m.<br>_____ ft. after _____ hrs. pumping _____ g.p.m.<br>Estimated maximum yield <u>1000</u> g.p.m.   |                               |                           |
| <u>Sand</u>   |  | <u>211</u>                     | <u>218</u>                            | 13. Water sample submitted: _____ mo./day/yr.<br><u>1</u> Yes <input checked="" type="checkbox"/> No Date _____   |                               |                           |
| <u>Fine sand w/clay</u>   |  | <u>218</u>                     | <u>227</u>                            | 14. Well head completion:<br><input type="checkbox"/> Pitless adapter <u>18</u> Inches above grade  |                               |                           |
| <u>Sandy Clay</u>   |  | <u>227</u>                     | <u>230</u>                            | 15. Well grouted? <u>Yes</u><br>With: <input type="checkbox"/> Neat cement <input type="checkbox"/> Bentonite <input checked="" type="checkbox"/> Concrete<br>Depth: From <u>0</u> ft. to <u>10</u> ft.   |                               |                           |
| <u>Fine sand w/clay</u>   |  | <u>230</u>                     | <u>234</u>                            | 16. Nearest source of possible contamination:<br>ft. <u>50</u> Direction <u>North</u> Type <u>Road</u><br>Well disinfected upon completion? <input checked="" type="checkbox"/> Yes <input type="checkbox"/> No   |                               |                           |
| <u>Sand</u>   |  | <u>234</u>                     | <u>244</u>                            | 17. Pump: _____ Not installed<br>Manufacturer's name <u>Western Land Pumps</u><br>Model number _____ HP <u>100</u> Volts <u>480</u><br>Length of drop pipe <u>250</u> ft. capacity <u>150</u> g.p.m.<br>Type:<br><input type="checkbox"/> Submersible <input checked="" type="checkbox"/> Turbine<br><input type="checkbox"/> Jet <input type="checkbox"/> Reciprocating<br><input type="checkbox"/> Centrifugal <input type="checkbox"/> Other |                               |                           |
| <u>Lime stone</u>   |  | <u>244</u>                     | <u>245</u>                            | 18. Elevation:  |                               |                           |
| <u>Sand + gravel</u>  |  | <u>245</u>                     | <u>258</u>                            | 19. Remarks:  |                               |                           |
| <u>Sand</u>   |  | <u>258</u>                     | <u>261</u>                            | 20. Water well contractor's certification:<br>This well was drilled under my jurisdiction and this report is true to the best of my knowledge and belief.<br><u>Corder Drilling</u> <u>114</u><br>Business name _____ License No. _____<br>Address <u>Selden Ks</u><br>Signed <u>Elmer Corder</u> Date <u>5-3-76</u><br>Authorized representative   |                               |                           |
| <u>Shale</u>  |  | <u>261</u>                     | <u>263</u>                            | (Use a second sheet if needed)  |                               |                           |
| Topography:<br><input type="checkbox"/> Hill<br><input checked="" type="checkbox"/> Slope<br><input type="checkbox"/> Upland<br><input type="checkbox"/> Valley |  | (Use a second sheet if needed) |                                       |   |                               |                           |

Forward the white, blue and pink copies to the Department of Health and Environment

Form WWC-5