

USE TYPEWRITER OR BALL POINT PEN-PRESS FIRMLY, PRINT CLEARLY.


WATER WELL RECORD
KSA 82-1201-1215

Kansas Department of Health and Environment-Division of Environment
(Water well Contractors)
Topeka, Kansas 66620

CDA CAD

1. Location of well: County Sheridan Fraction NE SE SE 1/4 XNE 1/4 SW 1/4 Section number 10 Township number T 8 Range number S R 29 XW

2. Distance and direction from nearest town or city: Sequin Rd on HWY 24; 3 E; 1S; 1/2W; 1/2N; West to road
Street address of well location if in city:
3. Owner of well: Darrell Allen
R.R. or street:
City, state, zip code: Hoxie, KS

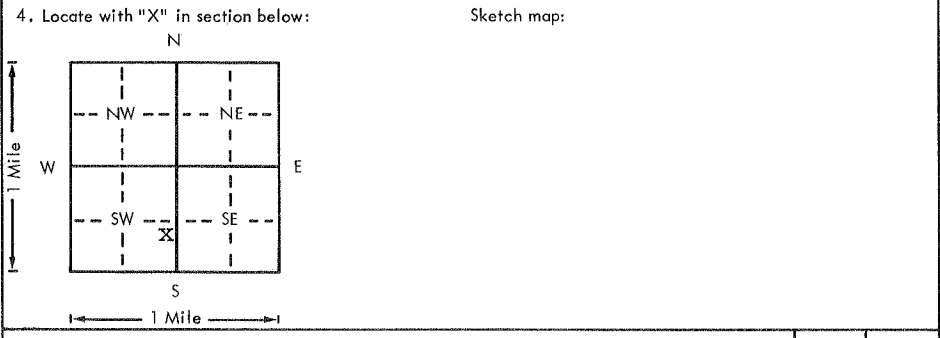

6. Bore hole dia. 30 in. Completion date 1-22-77
Well depth 258 ft.
7. Cable tool Rotary Driven Dug
 Hollow rod Jetted Bored Reverse rotary
8. Use: Domestic Public supply Industry
 Irrigation Air conditioning Stock
 Lawn Oil field water Other
9. Casing: Material Steel Height: Above or below XXX
Threaded Welded Surface 12 in.
RMP PVC Weight .188 lbs./ft.
Dia. 16 in. to 168 ft. depth Wall thickness: inches or
Dia. 10 in. to 248 ft. depth gauge No. #7

5. Type and color of material	From	To
Clay, Coarse Sand, Sandstone Streaks	0	160
Clay, Coarse Sand Streaks	160	180
Clay, Coarse Sand Streaks, Sandstone	180	200
Clay, Coarse Sand Streaks	200	230
Coarse Sand, Med. Gravel, Clay Streaks	230	256
Ochre, Shale	256	258
<u>BROCK 256'</u>		
(Use a second sheet if needed)		

10. Screen: Manufacturer's name Brown
Type Regular Dia. 16"
Slot/gauze 10% Length 80'
Set between 168 ft. and 248 ft.
10 Cook 248 ft. and 258 ft.
Gravel pack? Size range of material: 30% #1 70% #5
11. Static water level: 146 ft. below land surface Date 1-26-77 mo./day/yr.
12. Pumping level below land surfaces:
256 ft. after 2 hrs. pumping 869 g.p.m.
 ft. after hrs. pumping g.p.m.
Estimated maximum yield 869 g.p.m.
13. Water sample submitted: mo./day/yr.
 Yes No Date
14. Well head completion:
 Pitless adapter 12 Inches above grade
15. Well grouted?
With: Neat cement Bentonite Concrete
Depth: From 0 ft. to 10 ft.
16. Nearest source of possible contamination:
ft. 5000 Direction NW Type House
Well disinfected upon completion? Yes No
17. Pump: Not installed
Manufacturer's name Floway
Model number 85078 HP 100 Volts
Length of drop pipe 250 ft. capacity g.p.m.
Type:
 Submersible Turbine
 Jet Reciprocating
 Centrifugal Other

18. Elevation: Topography: Hill Slope Upland Valley
19. Remarks: 2858 (TOPO)
2860

20. Water well contractor's certification:
This well was drilled under my jurisdiction and this report is true to the best of my knowledge and belief.
Western Well & Pump 245
Business name Box 852 Colby, KS License No.
Address
Signed: Sally Berry Date 2/23/77
Authorized representative

T 8 29 W
R 10
Sec 1/4 NE SE SW