


1 LOCATION OF WATER WELL: Fraction $\frac{1}{4}$ $\frac{1}{4}$ SE $\frac{1}{4}$ Section Number 19 Township Number T 8 S Range Number R 29 E

Distance and direction from nearest town or city street address of well if located within city?
In city of Sequima, Ks.

2 WATER WELL OWNER: RR#, St. Address, Box # : City, State, ZIP Code : Tim Cheney Board of Agriculture, Division of Water Resources Application Number:

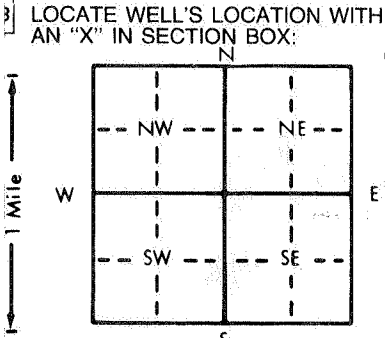

4 DEPTH OF COMPLETED WELL: 220/203 ft. ELEVATION: ...
 Depth(s) Groundwater Encountered 1. 106 ft. 2. ... ft. 3. ... ft.
 WELL'S STATIC WATER LEVEL 106 ft. below land surface measured on mo/day/yr
 Pump test data: Well water was ... ft. after ... hours pumping ... gpm
 Est. Yield ... gpm: Well water was ... ft. after ... hours pumping ... gpm
 Bore Hole Diameter 8 in. to ... ft., and ... in. to ... ft.
 WELL WATER TO BE USED AS: 5 Public water supply 8 Air conditioning 11 Injection well
 1 Domestic 3 Feedlot 6 Oil field water supply 9 Dewatering 12 Other (Specify below)
 2 Irrigation 4 Industrial 7 Lawn and garden only 10 Observation well
 Was a chemical/bacteriological sample submitted to Department? Yes ... No X; If yes, mo/day/yr sample was submitted
 Water Well Disinfected? Yes ... No X

5 TYPE OF BLANK CASING USED: 5 Wrought iron 8 Concrete tile CASING JOINTS: Glued Clamped
 1 Steel 3 RMP (SR) 6 Asbestos-Cement 9 Other (specify below) Welded
 2 PVC 4 ABS 7 Fiberglass Threaded
 Blank casing diameter 4 in. to 203 ft. Dia ... in. to ... ft. Dia ... in. to ... ft.
 Casing height above land surface 12 in., weight 160 lbs./ft. Wall thickness or gauge No.

TYPE OF SCREEN OR PERFORATION MATERIAL: 7 PVC 10 Asbestos-cement
 1 Steel 3 Stainless steel 5 Fiberglass 8 RMP (SR) 11 Other (specify)
 2 Brass 4 Galvanized steel 6 Concrete tile 9 ABS 12 None used (open hole)

SCREEN OR PERFORATION OPENINGS ARE: 5 Gauzed wrapped 8 Saw cut 11 None (open hole)
 1 Continuous slot 3 Mill slot 6 Wire wrapped 9 Drilled holes
 2 Louvered shutter 4 Key punched 7 Torch cut 10 Other (specify)

SCREEN-PERFORATED INTERVALS: From 200 ft. to 223 ft. From ... ft. to ... ft.
 From ... ft. to ... ft. From ... ft. to ... ft.
 GRAVEL PACK INTERVALS: From 20 ft. to 223 ft. From ... ft. to ... ft.
 From ... ft. to ... ft. From ... ft. to ... ft.

6 GROUT MATERIAL: 1 Neat cement 2 Cement grout 3 Bentonite 4 Other
 Grout Intervals: From 5 ft. to 20 ft., From ... ft. to ... ft., From ... ft. to ... ft.

What is the nearest source of possible contamination:
 1 Septic tank 4 Lateral lines 7 Pit privy 10 Livestock pens 14 Abandoned water well
 2 Sewer lines 5 Cess pool 8 Sewage lagoon 11 Fuel storage 15 Oil well/Gas well
 3 Watertight sewer lines 6 Seepage pit 9 Feedyard 12 Fertilizer storage 16 Other (specify below)
 13 Insecticide storage

Direction from well? 220 SW How many feet? 220 ft.

FROM	TO	LITHOLOGIC LOG	FROM	TO	LITHOLOGIC LOG
0	30	Top soil	0	0	
30	55	Clay + Sandy Clay	0	0	
55	80	Sand - gravel	0	0	
80	93	Sandy clay	0	0	
93	120	gravel	0	0	
120	129	Sandy clay	0	0	
129	173	gravel - sand	0	0	
173	195	Clay - sandy clay	0	0	
195	215	gravel	0	0	
215	223	clay - shale	0	0	

7 CONTRACTOR'S OR LANDOWNER'S CERTIFICATION: This water well was (1) constructed, (2) reconstructed, or (3) plugged under my jurisdiction and was completed on (mo/day/year) 11-19-86 and this record is true to the best of my knowledge and belief. Kansas Water Well Contractor's License No. 214 This Water Well Record was completed on (mo/day/yr) 12-2-86 under the business name of Blue Jay Drilling Co Inc by (signature) Suber Hall
 INSTRUCTIONS: Use typewriter or ball point pen, PLEASE PRESS FIRMLY and PRINT clearly. Please fill in blanks, underline or circle the correct answers. Send top three copies to Kansas Department of Health and Environment, Division of Environment, Environmental Geology Section, Topeka, KS 66620. Send one to WATER WELL OWNER and retain one for your records.