

USE TYPEWRITER OR BALL POINT PEN-PRESS FIRMLY, PRINT CLEARLY.

MENUG ST


T R EW sec 1/4 1/4 1/4 No.

WATER WELL RECORD
KSA 82a-1201-1215

Kansas State Dept. Of Health
(Water Well Contractors)
Forbes-Bldg. 740
Topeka, Kansas 66620

1 Location of well: County Sheridan Township name Logan Fraction NW 1/4 OF NE 1/4 Section number 22 Town number T8S Range number R 29 W

Distance and direction from nearest town or city: 3 miles East of Sequin
Street address of well location if in city: Sequin
3 Owner of well: Harold Selbe
Address: Hoxie, Kansas

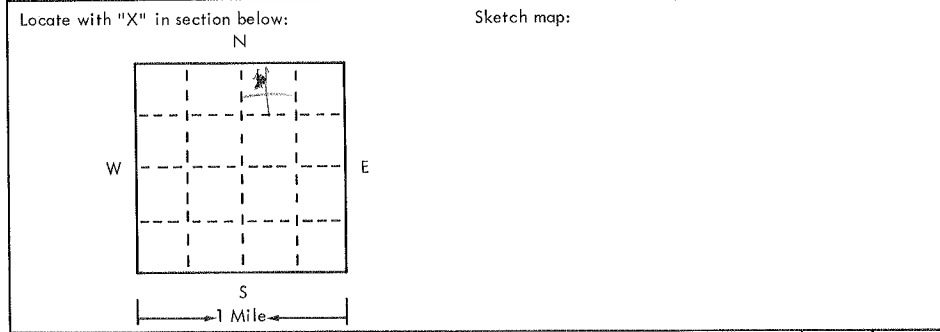

4 Well depth: 227 ft. Date of completion 1-20-75
Well diameter 28 in.
5 Cable tool Rotary Driven Dug
 Hollow rod Jetted Bored Reverse rotary
6 Use: Domestic Public supply Industry
 Irrigation Air conditioning Commercial
 Test well _____
7 Casing: Material steel Height: above/below
Threaded Welded Surface 12 in.
Pip. 137 Weight 7 gauge
 in. to ft. depth Drive shoe? Yes No
 in. to ft. depth

2	Type and color of material	From	To
	Clay & sand streaks	0	74
	Fine to coarse sand & gravel & few clay lenses	74	87
	Sandy clay	87	109
	Fine to coarse sand & fine gravel & few clay L.	109	121
	Fine to coarse sand & gravel	121	125
	Sandy clay	125	130
	Fine to coarse sand & gravel & few clay streaks	130	145
	Sandy clay	145	149
	Fine to coarse sand & gravel & clay lenses	149	160
	Sandy clay & fine to coarse sand & gravel	160	164
	Fine to coarse sand & fine gravel & clay lenses	164	176
	Fine to coarse sand & gravel & clay	176	179
	Fine to coarse sand & gravel	179	190
	Fine to coarse sand & fine to medium gravel	190	199
	Fine to coarse sand & sandy clay	199	225
	Shale (use a second sheet if needed)	225	227

8 Screen: Manufacturer W. A. Brown
Type bridge Dia. 16"
Slot/gauze 1 1/8 Length 2"
Set between 137 ft. and 217 ft.
Fittings 10' of cook 217-227
Gravel pack Yes No Size range of material 1/4" x 5/8"
9 Static water level: 75 ft. below land surface Date 1-6-75
10 Pumping level below land surfaces:
140 ft. after 2 hrs. pumping 1200 g.p.m.
 ft. after hrs. pumping g.p.m.
Estimated maximum yield 1300 g.p.m.

11 Water sample submitted: Yes No Date _____
12 Well head completion: Pitless adapter 12 inches above grade
13 Well grouted? Yes No
 Neat cement Bentonite & clay
Depth: From 0 ft. to 10 ft.
14 Nearest source of possible contamination:
ft. 1/2 mile Direction West Type unknown
Well disinfected upon completion? Yes No

15 Pump: Not installed
Manufacturer's name Johnston
Model number 8 HP 100 Volts _____
Length of drop pipe 220 ft. capacity 1000 g.p.p.
Type:
 Submersible Turbine
 Jet Reciprocating
 Centrifugal Other

16 Remarks: elevation 2815 (TOPO)
Topography:
 Hill
 Slope
 Upland
 Valley

17 Water well contractor's certification:
This well was drilled under my jurisdiction and this report is true to the best of my knowledge and belief.
Western Well & Pump Inc. 245
Business name Box 852, Colby, Ks. License No. _____
Address _____
Signed Roy F. Sanjour Date 2-25-75
Authorized representative