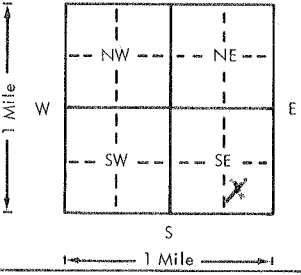


USE TYPEWRITER OR BALL POINT PEN-PRESS FIRMLY, PRINT CLEARLY.

WATER WELL RECORD
KSA 82a-1201-1215

Kansas Department of Health and Environment-Division of Environment
(Water well Contractors)
Topeka, Kansas 66620

DDB

1. Location of well:		County <u>Sedgewick</u>	Fraction <u>NW 1/4 SE 1/4 SE 1/4 SE 1/4</u>	Section number <u>27</u>	Township number T <u>8</u> S R	Range number <u>29</u> E/W
2. Distance and direction from nearest town or city: Street address of well location if in city: <u>15 + 3E from Sequim St.</u>			3. Owner of well: <u>Fred Wessel</u> R.R. or street: City, state, zip code: <u>Selden Kansas 67757</u>			
4. Locate with "X" in section below: Sketch map: 			6. Bore hole dia <u>28</u> in. Completion date <u>8-29-79</u> Well depth <u>198</u> ft.			
5. Type and color of material			7. <input type="checkbox"/> Cable tool <input type="checkbox"/> Rotary <input type="checkbox"/> Driven <input type="checkbox"/> Dug <input type="checkbox"/> Hollow rod <input type="checkbox"/> Jetted <input type="checkbox"/> Bored <input checked="" type="checkbox"/> Reverse rotary			
			8. Use: <input type="checkbox"/> Domestic <input type="checkbox"/> Public supply <input type="checkbox"/> Industry <input checked="" type="checkbox"/> Irrigation <input type="checkbox"/> Air conditioning <input type="checkbox"/> Stock <input type="checkbox"/> Lawn <input type="checkbox"/> Oil field water <input type="checkbox"/> Other			
			9. Casing: Material <u>Steel</u> Height: Above or below Threaded <input type="checkbox"/> Welded <input checked="" type="checkbox"/> Surface <u>12</u> in. RMP <input type="checkbox"/> PVC <input type="checkbox"/> Weight _____ lbs./ft. Dia <u>16</u> in. to <u>198</u> ft. depth Wall Thickness: inches or Dia. _____ in. to _____ ft. depth gauge No. <u>188</u>			
			10. Screen: Manufacturer's name <u>WABROWN</u> Type <u>LOVER</u> Dia. <u>16</u> Slot/gauze <u>7/8</u> Length <u>60</u> Set between <u>198</u> ft. and <u>138</u> ft. _____ ft. and _____ ft. Gravel pack? <input checked="" type="checkbox"/> Size range of material <u>7/4 + 3/8</u>			
			11. Static water level: _____ mo./day/yr. <u>93</u> ft. below land surface Date <u>8-29-79</u>			
			12. Pumping level below land surfaces: _____ ft. after _____ hrs. pumping _____ g.p.m. _____ ft. after _____ hrs. pumping _____ g.p.m. Estimated maximum yield <u>1400</u> g.p.m.			
			13. Water sample submitted: _____ mo./day/yr. Yes <input checked="" type="checkbox"/> No <input type="checkbox"/> Date _____			
			14. Well head completion: <input type="checkbox"/> Pitless adapter <u>12</u> Inches above grade			
			15. Well grouted? <u>yes</u> With: <input checked="" type="checkbox"/> Neat cement <input type="checkbox"/> Bentonite <input type="checkbox"/> Concrete Depth: From <u>0</u> ft. to <u>10</u> ft.			
			16. Nearest source of possible contamination: <u>None</u> ft. _____ Direction _____ Type _____ Well disinfected upon completion? <input type="checkbox"/> Yes <input checked="" type="checkbox"/> No			
			17. Pump: <input checked="" type="checkbox"/> Not installed Manufacturer's name _____ Model number _____ HP _____ Volts _____ Length of drop pipe _____ ft. capacity _____ g.p.m. Type: <input type="checkbox"/> Submersible <input type="checkbox"/> Turbine <input type="checkbox"/> Jet <input type="checkbox"/> Reciprocating <input type="checkbox"/> Centrifugal <input type="checkbox"/> Other			
18. Elevation:			19. Remarks:			
Topography: <input type="checkbox"/> Hill <input type="checkbox"/> Slope <input checked="" type="checkbox"/> Upland <input type="checkbox"/> Valley			(Use a second sheet if needed)			
			20. Water well contractor's certification: This well was drilled under my jurisdiction and this report is true to the best of my knowledge and belief. <u>BLUE JAY DRILLING CO INC 214</u> Business name _____ License No. _____ Address <u>BOLBY KANS</u> Signed <u>Marilyn Rall</u> Date <u>8-29-79</u> Authorized representative			

