


**1 LOCATION OF WATER WELL:** County: Clay Fraction: SE 1/4 NE 1/4 SE 1/4 Section Number: 7 Township Number: 8 Range Number: 3  EW

Distance and direction from nearest town or city street address of well if located within city?

300 W of Intersection 4th and Harriet Clay Center Ks

**2 WATER WELL OWNER:** RR#, St. Address, Box #: Valley Fertilizer 118 W Court St City, State ZIP Code: Beloit Ks

**Global Positioning Systems (decimal degrees, min. of 4 digits)**  
 Latitude: \_\_\_\_\_  
 Longitude: \_\_\_\_\_  
 Elevation: \_\_\_\_\_  
 Datum: \_\_\_\_\_  
 Data Collection Method: \_\_\_\_\_

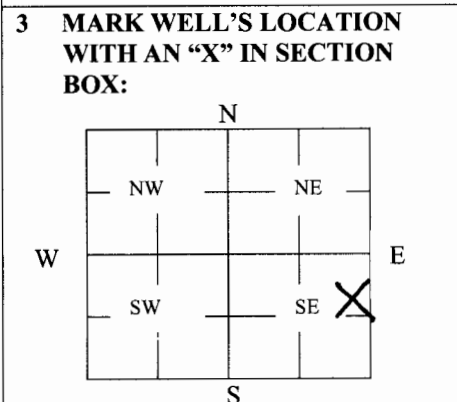

**4 DEPTH OF WELL** 59 ft.  
 WELL'S STATIC WATER LEVEL 20 ft.  
 WELL WAS USED AS:

1 Domestic	5 Public Water Supply	9 Dewatering
2 Irrigation	6 Oil Field Water Supply	<input checked="" type="radio"/> 10 Monitoring
3 Feedlot	7 Domestic (Lawn & Garden)	11 Injection Well
4 Industrial	8 Air Conditioning	12 Other _____

Was a chemical/bacteriological sample submitted to Department? Yes \_\_\_\_\_ No

**5 TYPE OF BLANK CASING USED:**

<input checked="" type="radio"/> 1 Steel	<input type="radio"/> 3 RMP (SR)	<input type="radio"/> 5 Wrought	<input type="radio"/> 7 Fiberglass	<input type="radio"/> 9 Other (Specify below)
<input checked="" type="radio"/> 2 PVC	<input type="radio"/> 4 ABS	<input type="radio"/> 6 Asbestos-Cement	<input type="radio"/> 8 Concrete Tile	_____

Blank casing diameter 2 in. Was casing pulled? Yes \_\_\_\_\_ No  If yes, how much \_\_\_\_\_  
 Casing height above or below land surface 30 in.

**6 GROUT PLUG MATERIAL:**  1 Neat cement  2 Cement grout  3 Bentonite  4 Other \_\_\_\_\_

Grout Plug Intervals: From 0 ft. to 59 ft., From ? ft. to ? ft., From \_\_\_\_\_ to \_\_\_\_\_ ft.

What is the nearest source of possible contamination:

<input type="radio"/> 1 Septic tank	<input type="radio"/> 6 Seepage pit	<input type="radio"/> 11 Fuel Storage	<input checked="" type="radio"/> 16 Other (specify below)
<input type="radio"/> 2 Sewer lines	<input type="radio"/> 7 Pit privy	<input type="radio"/> 12 Fertilizer storage	<u>UNK</u>
<input type="radio"/> 3 Watertight sewer lines	<input type="radio"/> 8 Sewage lagoon	<input type="radio"/> 13 Insecticide storage	
<input type="radio"/> 4 Lateral lines	<input type="radio"/> 9 Feedyard	<input type="radio"/> 14 Abandoned water well	Direction from well? _____
<input type="radio"/> 5 Cess pool	<input type="radio"/> 10 Livestock pens	<input type="radio"/> 15 Oil well/Gas well	How many feet? _____

FROM	TO	PLUGGING MATERIALS	FROM	TO	PLUGGING MATERIALS
<u>0</u>	<u>59.5</u>	<u>Bentonite Hole Plug</u>			

**7 CONTRACTOR'S OR LANDOWNER'S CERTIFICATION:** This water well was plugged under my jurisdiction and was completed on (mo/day/year) 07-14-15 and this record is true to the best of my knowledge and belief. Kansas Water Well Contractor's License No. 388. This Water Well Record was completed on (mo/day/year) 07-23-13 under the business name of PESTINGER PUMP SERVICE by (signature) David Pester

**INSTRUCTIONS:** Use typewriter or ballpoint pen. Please press firmly and print clearly. Please fill in blanks, underline or circle the correct answers. Send top three copies to Kansas Department of Health and Environment, Bureau of Water, Geology Section, 1000 SW Jackson St., Ste. 420, Topeka, Kansas 66612-1367. Telephone: 785/296-5522. Send one to Water Well Owner and retain one for your records. Visit us at <http://www.kdheks.gov/geo/waterwells>.