


WATER WELL RECORD

Form WWC-5

Division of Water Resources App. No. 20109070

1 LOCATION OF WATER WELL: Fraction Section Number Township Number Range Number
County: Sheridan 1/4 NE 1/4 SW 1/4 SE 4 T 8 S R 30
Street/Rural Address of Well Location; if unknown, distance & direction from nearest town or intersection: If at owner's address, check here.

2 WATER WELL OWNER: No. 8 Company LLC
RR#, St. Address, Box # %Marie Meier
City, State, ZIP Code P. O. Box 793
Hoxie, Ks 67740
Global Positioning System (GPS) information:
Latitude: (in decimal degrees)
Longitude: (in decimal degrees)
Elevation:
Datum: WGS 84, NAD 83, NAD 27
Collection Method:
GPS unit (Make/Model):
Digital Map/Photo, Topographic Map, Land Survey
Est. Accuracy: <3 m, 3-5 m, 5-15 m, >15 m

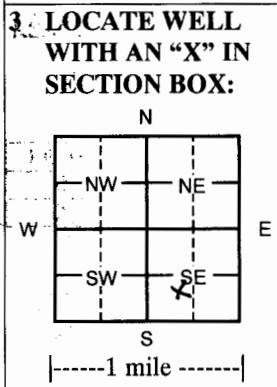

3 LOCATE WELL WITH AN 'X' IN SECTION BOX:
4 DEPTH OF COMPLETED WELL Sheet 1 of 2
273 ft.
Depth(s) Groundwater Encountered (1) ft. (2) ft. (3) ft.
WELL'S STATIC WATER LEVEL 200 ft. below land surface measured on mo/day/yr
Pump test data: Well water was ft. after hours pumping gpm
EST. YIELD gpm: Well water was ft. after hours pumping gpm
WELL WATER TO BE USED AS: Public water supply, Geothermal, Injection well, Domestic, Feedlot, Oil field water supply, Dewatering, Other (Specify below), Irrigation, Industrial, Domestic-lawn & garden, Monitoring well
Was a chemical/bacteriological sample submitted to Department? Yes No
If yes, mo/day/yr sample was submitted
Water Well Disinfected? Yes No

5 TYPE OF CASING USED: Steel, PVC, Other
CASING JOINTS: Glued, Clamped, Welded, Threaded
Casing diameter 16 in. to 213 ft., Diameter in. to ft., Diameter in. to ft.
Casing height above land surface 24 in., Weight 16.15 lbs./ft. Wall thickness or gauge No. 500
TYPE OF SCREEN OR PERFORATION MATERIAL: Steel, Stainless Steel, PVC, Other (Specify), Brass, Galvanized Steel, None used (open hole)
SCREEN OR PERFORATION OPENINGS ARE: Continuous Slot, Mill slot, Gauze wrapped, Torch cut, Drilled holes, None (open hole), Louvered shutter, Key punched, Wire wrapped, Saw cut, Other (specify)
SCREEN-PERFORATED INTERVALS: From 213 ft. to 273 ft., From ft. to ft., From ft. to ft.
GRAVEL PACK INTERVALS: From 20 ft. to 273 ft., From ft. to ft., From ft. to ft.

6 GROUT MATERIAL: Neat cement, Cement grout, Bentonite, Other
Grout Intervals From 0 ft. to 20 ft. From ft. to ft. From ft. to ft.
What is the nearest source of possible contamination:
Septic tank, Lateral lines, Pit privy, Livestock pens, Insecticide storage, Other (specify below)
Sewer lines, Cesspool, Sewage lagoon, Fuel storage, Abandoned water well
Watertight sewer lines, Seepage pit, Feedyard, Fertilizer storage, Oil well/gas well, Old well
Direction from well NE Distance from well 300 ft

Table with columns: FROM, TO, LITHOLOGIC LOG, FROM, TO, LITHO. LOG (cont.) or PLUGGING INTERVALS. Rows describe geological layers from surface down to 238 ft.

7 CONTRACTOR'S OR LANDOWNER'S CERTIFICATION: This water well was constructed, reconstructed, or plugged under my jurisdiction and was completed on (mo/day/year) 7-01-2010 and this record is true to the best of my knowledge and belief. Kansas Water Well Contractor's License No. 554 or 783. This Water Well Record was completed on (mo/day/year) 7-10-2010 under the business name of Woofter Pump & Well Inc. by (signature)

INSTRUCTIONS: Please fill in blanks and check the correct answers. Send three copies (white, blue, pink) to Kansas Department of Health and Environment, Bureau of Water, Geology Section, 1000 SW Jackson St., Suite 420, Topeka, Kansas 66612-1367. Telephone 785-296-5522. Send one to WATER WELL OWNER and retain one for your records. Include fee of \$5.00 for each constructed well. Visit us at http://www.kdheks.gov/waterwell/index.html.

WATER WELL RECORD

Form WWC-5

Division of Water Resources App. No. **20109070**

1 LOCATION OF WATER WELL: Fraction ¼ NE ¼ SW ¼ SE ¼ Section Number 4 Township Number T 8 S Range Number R 30 E W

County: **Sheridan**

Street/Rural Address of Well Location; if unknown, distance & direction from nearest town or intersection: If at owner's address, check here **Global Positioning System (GPS) information:**
 Latitude: _____ (in decimal degrees)
 Longitude: _____ (in decimal degrees)
 Elevation: _____
 Datum: WGS 84, NAD 83, NAD 27
 Collection Method:
 GPS unit (Make/Model: _____)
 Digital Map/Photo, Topographic Map, Land Survey
 Est. Accuracy: <3 m, 3-5 m, 5-15 m, >15 m

2 WATER WELL OWNER: No. 8 Company LLC
 RR#, St. Address, Box # %Marie Meier
 City, State, ZIP Code P. O. Box 793
Hoxie, Ks 67740

3 LOCATE WELL WITH AN "X" IN SECTION BOX:

N	
NW	NE
SW	SE
S	

W E

-----1 mile-----

4 DEPTH OF COMPLETED WELL 273 ft. **Sheet 2 of 2**
 Depth(s) Groundwater Encountered (1) _____ ft. (2) _____ ft. (3) _____ ft.
 WELL'S STATIC WATER LEVEL 200 ft. below land surface measured on mo/day/yr
 Pump test data: Well water was _____ ft. after _____ hours pumping _____ gpm
 EST. YIELD _____ gpm: Well water was _____ ft. after _____ hours pumping _____ gpm
 WELL WATER TO BE USED AS: Public water supply Geothermal Injection well
 Domestic Feedlot Oil field water supply Dewatering Other (Specify below)
 Irrigation Industrial Domestic-lawn & garden Monitoring well
 Was a chemical/bacteriological sample submitted to Department? Yes No
 If yes, mo/day/yr sample was submitted _____
 Water Well Disinfected? Yes No

5 TYPE OF CASING USED: Steel PVC Other
 CASING JOINTS: Glued Clamped Welded Threaded
 Casing diameter 16 in. to 213 ft., Diameter _____ in. to _____ ft., Diameter _____ in. to _____ ft.
 Casing height above land surface 24 in., Weight 16.15 lbs./ft. Wall thickness or gauge No. 500
 TYPE OF SCREEN OR PERFORATION MATERIAL:
 Steel Stainless Steel PVC Other (Specify) _____
 Brass Galvanized Steel None used (open hole)
 SCREEN OR PERFORATION OPENINGS ARE:
 Continuous Slot Mill slot Gauze wrapped Torch cut Drilled holes None (open hole)
 Louvered shutter Key punched Wire wrapped Saw cut Other (specify) _____
 SCREEN-PERFORATED INTERVALS: From 213 ft. to 273 ft., From _____ ft. to _____ ft.
 From _____ ft. to _____ ft., From _____ ft. to _____ ft.
 GRAVEL PACK INTERVALS: From 20 ft. to 273 ft., From _____ ft. to _____ ft.
 From _____ ft. to _____ ft., From _____ ft. to _____ ft.

6 GROUT MATERIAL: Neat cement Cement grout Bentonite Other _____
 Grout Intervals From 0 ft. to 20 ft. From _____ ft. to _____ ft. From _____ ft. to _____ ft.
 What is the nearest source of possible contamination:
 Septic tank Lateral lines Pit privy Livestock pens Insecticide storage Other (specify below)
 Sewer lines Cesspool Sewage lagoon Fuel storage Abandoned water well
 Watertight sewer lines Seepage pit Feedyard Fertilizer storage Oil well/gas well **Old well**
 Direction from well NE Distance from well 300 ft

FROM	TO	LITHOLOGIC LOG	FROM	TO	LITHO. LOG (cont.) or PLUGGING INTERVALS
238	242	Clay			
242	251	fine sd w/clay strks & caliche lenses			
251	260	Fine to med sd w/clay lens			
260	266	Fine to med sd & small gravel			
266	275	Yellow ochre			

7 CONTRACTOR'S OR LANDOWNER'S CERTIFICATION: This water well was constructed, reconstructed, or plugged under my jurisdiction and was completed on (mo/day/year) 7-01-2010 and this record is true to the best of my knowledge and belief.
 Kansas Water Well Contractor's License No. 554 of 783. This Water Well Record was completed on (mo/day/year) 7-10-2010
 under the business name of Woofter Pump & Well Inc. by (signature) _____

INSTRUCTIONS: Please fill in blanks and check the correct answers. Send three copies (white, blue, pink) to Kansas Department of Health and Environment, Bureau of Water, Geology Section, 1000 SW Jackson St., Suite 420, Topeka, Kansas 66612-1367. Telephone 785-296-5522. Send one to WATER WELL OWNER and retain one for your records. Include fee of \$5.00 for each constructed well. Visit us at http://www.kdheks.gov/waterwell/index.html.