


WATER WELL PLUGGING RECORD Form WWC-5P KSA 82a-1212 ID NO.

1 **LOCATION OF WATER WELL:** Fraction SW 1/4 SW 1/4 SE 1/4 SE 1/4 Section Number 32 Township Number T 8 S Range Number 30 E W
 County: Sheridan

Street/Rural Address of Well Location; if unknown, distance & direction from nearest town or intersection: If at owner's address, check here 13200 West Road 405 Rexford, KS 67753
Global Positioning Systems (GPS) information:
 Latitude: 39.307450 (in decimal degrees)
 Longitude: -100.688378 (in decimal degrees)
 Elevation: _____
 Horizontal Datum: WGS84, NAD83, NAD27
 Collection Method: _____

2 **WATER WELL OWNER:** Lenny Patman
 RR#, St. Address, Box #: 2049 W Hwy 24
 City, State ZIP Code: Hoxie KS 67740
 GPS unit (Make/Model: _____)
 Digital Map/Photo, Topographic Map, Land Survey
 Est. Accuracy: <3 m, 3-5 m, 5-15 m, >15 m

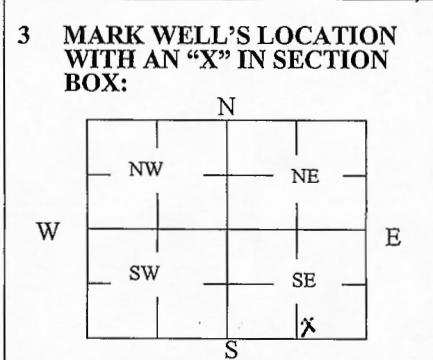

4 **DEPTH OF WELL** 120 ft.
 WELL'S STATIC WATER LEVEL Dry ft.
 WELL WAS USED AS:
 Domestic Public Water Supply Dewatering
 Irrigation Oil Field Water Supply Monitoring
 Feedlot Domestic (Lawn & Garden) Injection Well
 Industrial Air Conditioning Other _____
 Was a chemical/bacteriological sample submitted to Department? Yes No

5 **TYPE OF BLANK CASING USED:**
 Steel RMP (SR) Wrought Fiberglass Other (Specify below)
 PVC ABS Asbestos-Cement Concrete Tile
 Blank casing diameter 5' in. Was casing pulled? Yes No If yes, how much _____
 Casing height above or below land surface 60 in.

6 **GROUT PLUG MATERIAL:** Neat cement Cement grout Bentonite Other _____
 Grout Plug Intervals: From 120 ft. to 108 ft., From 17 ft. to 8 ft., From 8 ft. to 5 ft.
Bentonite Bentonite Neat Cement
 What is the nearest source of possible contamination:
 Septic tank Seepage pit Fuel storage Other (specify below)
 Sewer lines Pit privy Fertilizer storage
 Watertight sewer lines Sewage lagoon Insecticide storage
 Lateral lines Feedyard Abandoned water well Direction from well? N
 Cess pool Livestock pens Oil well/Gas well How many feet? 8'

FROM	TO	PLUGGING MATERIALS	FROM	TO	PLUGGING MATERIALS
120	108	Bentonite			
108	17	Clay			
17	8	Bentonite			
8	5	Neat Cement			
5	0	Compacted Clay + Topsoil			

7 **CONTRACTOR'S OR LANDOWNER'S CERTIFICATION:** This water well was plugged under my jurisdiction and was completed on (mo/day/year) 10-22-21 and this record is true to the best of my knowledge and belief. Kansas Water Well Contractor's License No. 663. This Water Well Record was completed on (mo/day/year) 10-29-21 under the business name of Brenn Pump & Supply by (signature) [Signature]

Send one white copy to Kansas Department of Health & Environment, Geology Section, 1000 SW Jackson Street, Ste. 420, Topeka, KS 66612-1367. Send one copy to WATER WELL OWNER and retain one for your records.
 Visit us at <http://www.kdheks.gov/waterwell/index.html> Telephone 785-296-5524.