

USE TYPEWRITER OR BALL POINT PEN-PRESS FIRMLY, PRINT CLEARLY.

156160 NW

T R EW sec 1/4 1/4 1/4 No.

WATER WELL RECORD
KSA 82a-1201-1215


CCC

Kansas State Dept. Of Health
(Water Well Contractors)
Forbes-Bldg, 740
Topeka, Kansas 66620

1 Location of well:	County Sheridan	Township name Logan SW-SW 1/4 of SW 1/4	Fraction SW 1/4 of SW 1/4	Section number 3	Town number 8	Range number 30
---------------------	---------------------------	---	-------------------------------------	----------------------------	-------------------------	---------------------------

Distance and direction from nearest town or city: **3 miles East & 1 mile North of Menlo, KS**

3 Owner of well: **JoAnne Kreie**
Address: **Great Bend, KS.**

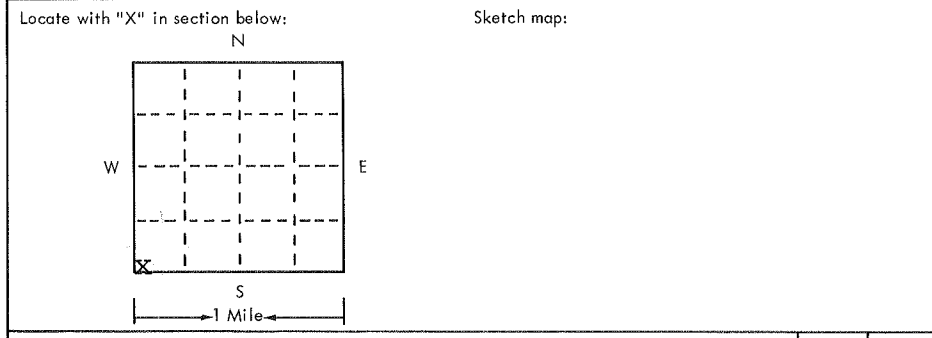

4 Well depth: 270 ft. Date of completion 4-3-75
Well diameter 28 in.

5 Cable tool Rotary Driven Dug
 Hollow rod Jetted Bored Reverse rotary

6 Use: Domestic Public supply Industry
 Irrigation Air conditioning Commercial
 Test well

7 Casing: Material Steel Height: above/below
Threaded Welded Surface 12 in.
Diam. 7 gauge/ft. 16 in. to 0 ft. depth Drive shoe? Yes No
16 in. to 160 ft. depth

2 Type and color of material	From	To
Clay and sand streaks	0	105
Fine to coarse sand and gravel and clay	105	165
Clay and sand streaks	165	182
Fine to coarse sand and gravel	182	195
Sandy clay	195	205
Cemented sand	205	213
Sandy clay and cemented streaks	213	218
Sandy clay	218	231
Fine to coarse sand and gravel	236	266
Ochre	266	270
BROCK 266'		
(use a second sheet if needed)		

8 Screen: Manufacturer W.A. Brown
Type Bridge Dia. 16"
Slot/gauze 1/8 Length 2"
Set between 160 ft. and 260 ft.
Fittings: 10' Cook - 260 - 270
Gravel pack Yes No Size range of material 1/4 x 5/

9 Static water level: 140 ft. below land surface Date 4-5-75

10 Pumping level below land surfaces:
220 ft. after 2 hrs. pumping 1600 g.p.m.
____ ft. after ____ hrs. pumping ____ g.p.m.
Estimated maximum yield 2000 g.p.m.

11 Water sample submitted:
 Yes No Date _____

12 Well head completion:
 Pitless adapter 12 inches above grade

13 Well grouted? Yes No
 Neat cement Bentonite & clay
Depth: From 0 ft. to 10 ft.

14 Nearest source of possible contamination:
ft. UNKNOWN Type _____
Well disinfected upon completion? Yes No

15 Pump: Not installed
Manufacturer's name Byron Jackson
Model number 10" HP 150 Volts _____
Length of drop pipe 250 ft. capacity _____ g.p.m.
Type:
 Submersible Turbine
 Jet Reciprocating
 Centrifugal Other

16 Remarks: elevation **2948 (TOPO)**

Topography:
 Hill
 Slope
 Upland
 Valley

17 Water well contractor's certification:
This well was drilled under my jurisdiction and this report is true to the best of my knowledge and belief.
Western Well & Pump, Inc. 245
Business name License No. _____
Address **Box 852, Colby, KS.**
Signed **Roy F. Lemire, Jr.** Date **6-14-75**
Authorized representative