USE TYPEWRITER OR BALL POINT PEN-PRESS FIRMLY, PRINT CLEARLY.

WATER WELL RECORD
KSA 82a-1201-1215

BBA

Kansas Department of Health and Environment-Division of Environment
(Water well Contractors)
Topeka, Kansas 66620

Job #284-77-B-3-8-30

X Location of well:	County	Fraction	Section number	Township number	Range number
	Sheridan	NE 1/4 NW 1/4 NW 1/4	3	T 8 S	R 30 ~~E~~/W

X. Distance and direction from nearest town or city: ~~Sequin; 4 N; 3¼ W~~ Menlo 5N; 3½ E
Street address of well location if in city:

3. Owner of well: JoAnne Kreie
R.R. or street: 2109 Cleveland
City, state, zip code: Great Bend, Kansas 67530

4. Locate with "X" in section below: Sketch map:

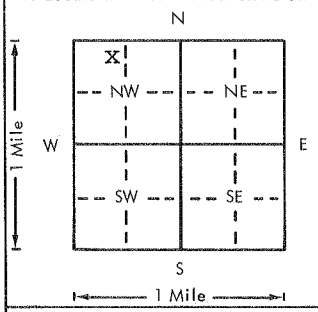

6. Bore hole dia. 30 in. Completion date 11-17-77
Well depth 254 ft.

7. __ Cable tool __ Rotary __ Driven __ Dug
__ Hollow rod __ Jetted __ Bored X Reverse rotary

8. Use: __ Domestic __ Public supply __ Industry
X Irrigation __ Air conditioning __ Stock
__ Lawn __ Oil field water __ Other

9. Casing: Material Steel Height: Above or ~~below~~ XXX
Threaded ___ Welded X Surface 12 in.
RMP ___ PVC ___ Weight .188 lbs./ft.
Dia. 16 in. to 164 ft. depth Wall Thickness: inches or
Dia. ___ in. to ___ ft. depth gage No. #7

5. Type and color of material	From	To
Clay	0	40
Gravel, Clay	40	140
Fine Sand, Clay	140	160
Coarse Sand, Med. Gravel	160	169
Fine Sand, Clay, Lime Streaks	169	191
Clay, Lime Streakswith Fine Sand	191	201
Fine Sand, Clay	201	218
Fine to Coarse Sand	218	225
Coarse Sand, Clay	225	240
Coarse Sand, Med. Gravel, Hard Streaks	240	252
Ochre, Shale	252	254
BROCK 252'		
(Use a second sheet if needed)		

10. Screen: Manufacturer's name Brown
Type Bridge Dia. 16"
Slot/gauze 10% Length 80'
Set between 164 ft. and 244 ft.
10' Cook ft. and 254 ft.
Gravel pack? X Size range of material ¼ x 5/8

11. Static water level: mo./day/yr.
139 ft. below land surface Date 11-18-77

12. Pumping level below land surfaces:
240 ft. after 2 hrs. pumping 525 g.p.m.
___ ft. after ___ hrs. pumping ___ g.p.m.
Estimated maximum yield 525 g.p.m.

13. Water sample submitted: mo./day/yr.
__ Yes X No Date

14. Well head completion:
__ Pitless adapter 12 Inches above grade

15. Well grouted? X
With: __ Neat cement X Bentonite X Concrete
Depth: From 0 ft. to 10 ft.

16. Nearest source of possible contamination:
ft. 2000' Direction NW Type House
Well disinfected upon completion? ___ Yes X No

17. Pump: X Not installed
Manufacturer's name
Model number HP Volts
Length of drop pipe ft. capacity g.p.m.
Type:
__ Submersible __ Turbine
__ Jet __ Reciprocating
__ Centrifugal __ Other

T 8 R 30 E (W) Sec 3 1/4 NE 1/4 1/4 1/4

18. Elevation:

Topography:
__ Hill
__ Slope
X Upland
__ Valley

19. Remarks:

20. Water well contractor's certification:
This well was drilled under my jurisdiction and this report is true to the best of my knowledge and belief.
Western Well & Pump 245
Business name License No.
Address Box 852 Colby, KS 67701
Signed Ann Hurstner Date 12/23/77
Authorized representative

Forward the white, blue and pink copies to the Department of Health and Environment

Form WWC-5

MI-1023