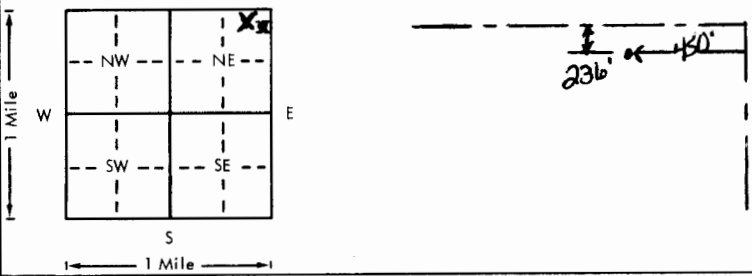


USE TYPEWRITER OR BALL
POINT PEN-PRESS FIRMLY,
PRINT CLEARLY.

WATER WELL RECORD
KSA 82a-1201-1215

Kansas Department of Health and
Environment-Division of Environment
(Water well Contractors)
Topeka, Kansas 66620

1. Location of well:		County Thomas	Fraction NE 1/4 NE 1/4 NE 1/4	Section number 9	Township number 8	Range number 31	E/W
2. Distance and direction from nearest town or city: 1 1/2 miles North; 2 3/4 West Street address of well location if in city:				3. Owner of well: Charles Stephens R.R. or street: RFD City, state, zip code: Menlo, Ks 67746			
4. Locate with "X" in section below:		Sketch map:		6. Bore hole dia. 30 in. Completion date 11-1-78 Well depth 255 ft.			
				7. <input type="checkbox"/> Cable tool <input type="checkbox"/> Rotary <input type="checkbox"/> Driven <input type="checkbox"/> Dug <input type="checkbox"/> Hollow rod <input type="checkbox"/> Jetted <input type="checkbox"/> Bored <input checked="" type="checkbox"/> Reverse rotary			
5. Type and color of material		From	To	8. Use: <input type="checkbox"/> Domestic <input type="checkbox"/> Public supply <input type="checkbox"/> Industry <input checked="" type="checkbox"/> Irrigation <input type="checkbox"/> Air conditioning <input type="checkbox"/> Stock <input type="checkbox"/> Lawn <input type="checkbox"/> Oil field water <input type="checkbox"/> Other			
Clay		0	70	9. Casing: Material Steel Height: Above or below Threaded <input type="checkbox"/> Welded <input checked="" type="checkbox"/> Surface 12 in. RMP <input type="checkbox"/> PVC <input type="checkbox"/> Weight 31.75 lbs./ft. Dia. 16 in. to 255 ft. depth Wall Thickness: inches or Dia. <input type="checkbox"/> in. to <input type="checkbox"/> ft. depth gage No. 188			
Sand & Gravel & Clay		70	128	10. Screen: Manufacturer's name Cook Type Wire Wrapped Dia. 16 Slot/gauze 100 Length 10 Set between 245 ft. and 255 ft. Brown Perforated 165 ft. and 245 ft. Gravel pack? <input checked="" type="checkbox"/> Size range of material 30% #1 70% #5/8			
Sand & Gravel		128	147	11. Static water level: 127 ft. below land surface Date 11-2-78			
Clay, Sand Streaks		147	160	12. Pumping level below land surfaces: 169 ft. after 2 hrs. pumping 1212 g.p.m. ft. after hrs. pumping g.p.m. Estimated maximum yield 1627 g.p.m.			
Coarse Sand & Gravel		160	167	13. Water sample submitted: mo./day/yr. <input type="checkbox"/> Yes <input checked="" type="checkbox"/> No Date			
Clay		167	180	14. Well head completion: <input type="checkbox"/> Pitless adapter 12 Inches above grade			
Sand & Gravel		180	183	15. Well grouted? Yes With: <input type="checkbox"/> Neat cement <input type="checkbox"/> Bentonite <input checked="" type="checkbox"/> Concrete Depth: From 0 ft. to 10 ft.			
Coliche		183	195	16. Nearest source of possible contamination: ft. 5000 Direction NW Type Farmstead Well disinfected upon completion? <input type="checkbox"/> Yes <input type="checkbox"/> No			
Coarse Sand & Gravel, Sandstone Streaks		204	217	17. Pump: <input type="checkbox"/> Not installed Manufacturer's name Floway Model number 12DOH HP 150 Volts Length of drop pipe 253 ft. capacity 1200 g.p.m. Type: <input type="checkbox"/> Submersible <input checked="" type="checkbox"/> Turbine <input type="checkbox"/> Jet <input type="checkbox"/> Reciprocating <input type="checkbox"/> Centrifugal <input type="checkbox"/> Other			
Clay		217	232	20. Water well contractor's certification: This well was drilled under my jurisdiction and this report is true to the best of my knowledge and belief. Western Well & Pump, Inc. 245 Business name Colby, KS 67701 License No. Address Signed O.D. Callahan Date 11/8/78 Authorized representative			
Medium Coarse Sand		232	239				
Clay		239	244				
Coarse Sand & Gravel		244	259				
Ochre & Shale (Use a second sheet if needed)		259	270				
18. Elevation:		19. Remarks: BROCK 359					
Topography: <input type="checkbox"/> Hill <input type="checkbox"/> Slope <input checked="" type="checkbox"/> Upland <input type="checkbox"/> Valley							

Forward the white, blue and pink copies to the Department of Health and Environment

Farm WWC-5