

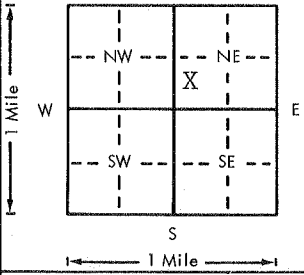
USE TYPEWRITER OR BALL
POINT PEN-PRESS FIRMLY,
PRINT CLEARLY.

ACB

WATER WELL RECORD
KSA 82a-1201-1215

Kansas Department of Health and
Environment-Division of Environment
(Water well Contractors)
Topeka, Kansas 66620

TWP: Menlo

1. Location of well:		County Thomas	Fraction NE 1/4 SW 1/4 NE 1/4	Section number 30	Township number T 8 S R	Range number 31 37 1W
2. Distance and direction from nearest town or city: From Menlo 6 miles West; 2 1/4 miles South Street address of well location if in city:				3. Owner of well: Jerry Fulwider R.R. or street: City, state, zip code: Brewster, Kansas		
4. Locate with "X" in section below:		Sketch map:		6. Bore hole dia. 30 in. Completion date 2/2/76 Well depth 250 ft.		
				7. <input type="checkbox"/> Cable tool <input type="checkbox"/> Rotary <input type="checkbox"/> Driven <input type="checkbox"/> Dug <input type="checkbox"/> Hollow rod <input type="checkbox"/> Jetted <input type="checkbox"/> Bored <input checked="" type="checkbox"/> Reverse rotary		
5. Type and color of material				8. Use: <input type="checkbox"/> Domestic <input type="checkbox"/> Public supply <input type="checkbox"/> Industry <input checked="" type="checkbox"/> Irrigation <input type="checkbox"/> Air conditioning <input type="checkbox"/> Stock <input type="checkbox"/> Lawn <input type="checkbox"/> Oil field water <input type="checkbox"/> Other		
				9. Casing: Material Steel Height: Above or below Threaded <input type="checkbox"/> Welded <input checked="" type="checkbox"/> Surface 12 in. RMP <input type="checkbox"/> PVC <input type="checkbox"/> Weight <input type="checkbox"/> lbs./ft. Dia. 16 in. to 160 ft. depth Wall Thickness: inches or Dia. <input type="checkbox"/> in. to <input type="checkbox"/> ft. depth gage No. 188		
				10. Screen: Manufacturer's name Brown 10' Cook Type Regular Dia. 16" Slot/gauze 10% Length 80' Set between 160 ft. and 240 ft. 240 ft. and 250 ft. Gravel pack? <input checked="" type="checkbox"/> Size range of material 1/4 X 5/8 50% #1		
				11. Static water level: <input type="checkbox"/> mo./day/yr. 130 ft. below land surface Date 2/7/76		
				12. Pumping level below land surfaces: 170 ft. after 2 hrs. pumping 556 g.p.m. 240 ft. after 2 hrs. pumping 961 g.p.m. Estimated maximum yield 961 g.p.m.		
				13. Water sample submitted: <input type="checkbox"/> Yes <input checked="" type="checkbox"/> No Date <input type="checkbox"/> mo./day/yr.		
				14. Well head completion: <input type="checkbox"/> Pitless adapter <input type="checkbox"/> 12 Inches above grade		
				15. Well grouted? <input checked="" type="checkbox"/> Clay With: <input type="checkbox"/> Neat cement <input checked="" type="checkbox"/> Bentonite <input checked="" type="checkbox"/> Concrete Depth: From 0 ft. to 10 ft.		
				16. Nearest source of possible contamination: ft. 2000 Direction NE Type Farm Well disinfected upon completion? <input type="checkbox"/> Yes <input checked="" type="checkbox"/> No		
				17. Pump: Manufacturer's name Floway Model number 7611 HP 100 Volts <input type="checkbox"/> Length of drop pipe 240 ft. capacity 550 g.p.m. Type: <input type="checkbox"/> Submersible <input checked="" type="checkbox"/> Turbine <input type="checkbox"/> Jet <input type="checkbox"/> Reciprocating <input type="checkbox"/> Centrifugal <input type="checkbox"/> Other		
18. Elevation:				20. Water well contractor's certification: This well was drilled under my jurisdiction and this report is true to the best of my knowledge and belief. Western Well & Pump 245 Business name PO Box 852 Colby, KS. License No. <input type="checkbox"/> Address 4-12-76 Signed Jerry Berry Date 4-12-76 Authorized representative		
19. Remarks: BROCK 247' (Use a second sheet if needed)						

Forward the white, blue and pink copies to the Department of Health and Environment

Form WWC-5