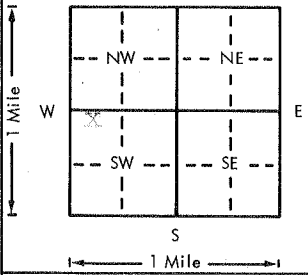


USE TYPEWRITER OR BALL  
POINT PEN-PRESS FIRMLY,  
PRINT CLEARLY.

WATER WELL RECORD  
KSA 82a-1201-1215

Kansas Department of Health and  
Environment-Division of Environment  
(Water well Contractors)  
Topeka, Kansas 66620

1. Location of well:	County <b>Thomas</b>	Fraction <b>NW 1/4 NW 1/4 SW 1/4</b>	Section number <b>30</b>	Township number <b>T 8 S R</b>	Range number <b>31 E/W</b>
2. Distance and direction from nearest town or city: <b>6W-2S of Menlo</b>			3. Owner of well: <b>XXXXXXXXXXXX Dale Farmer</b> R.R. or street: <b>Rt. 1 Box 69</b> City, state, zip code: <b>Menlo, Kansas</b>		
4. Locate with "X" in section below: 			Sketch map:		
5. Type and color of material			From	To	6. Bore hole dia. <b>8</b> in. Completion date <b>1/10/76</b> Well depth <b>245</b> ft.
Top Soil			100	10	7. Cable tool <input checked="" type="checkbox"/> Rotary <input type="checkbox"/> Driven <input type="checkbox"/> Dug <input type="checkbox"/> Hollow rod <input type="checkbox"/> Jetted <input type="checkbox"/> Bored <input type="checkbox"/> Reverse rotary
Clay			10	73	8. Use: <input checked="" type="checkbox"/> Domestic <input type="checkbox"/> Public supply <input type="checkbox"/> Industry <input type="checkbox"/> Irrigation <input type="checkbox"/> Air conditioning <input type="checkbox"/> Stock <input type="checkbox"/> Lawn <input type="checkbox"/> Oil field water <input type="checkbox"/> Other
Sandy Clay Strips			73	94	9. Casing: Material <b>plst</b> Height Above or below Threaded <input type="checkbox"/> Welded <input checked="" type="checkbox"/> Surface <b>15</b> in. RMP <input checked="" type="checkbox"/> PVC <input type="checkbox"/> Weight <input type="checkbox"/> lbs./ft. Dia. <b>5</b> in. to <b>245</b> ft. depth Wall Thickness: inches or Dia. <input type="checkbox"/> in. to <input type="checkbox"/> ft. depth gage No. <b>032</b>
Sand			94	113	10. Screen: Manufacturer's name <b>Jet Stream</b> Type <b>RMP</b> Dia. <b>5"</b> Slot/gauze <b>1/32"</b> Length <b>20'</b> Set between <input type="checkbox"/> ft. and <input type="checkbox"/> ft. <input checked="" type="checkbox"/> <b>225</b> ft. and <input checked="" type="checkbox"/> <b>245</b> ft. Gravel pack? <b>yes</b> Size range of material <b>1/8"</b>
Sand Rock			113	117	11. Static water level: <input type="checkbox"/> mo./day/yr. <b>140</b> ft. below land surface Date <b>1/10/76</b>
Sand			117	124	12. Pumping level below land surfaces: <input type="checkbox"/> ft. after <b>NA</b> hrs. pumping <input type="checkbox"/> g.p.m. <input type="checkbox"/> ft. after <input type="checkbox"/> hrs. pumping <input type="checkbox"/> g.p.m. Estimated maximum yield <input type="checkbox"/> g.p.m.
Sandy Clay			124	133	13. Water sample submitted: <input type="checkbox"/> Yes <input checked="" type="checkbox"/> No Date <input type="checkbox"/>
Sand			133	161	14. Well head completion: <input checked="" type="checkbox"/> Pitless adapter <b>20"</b> Inches above grade
Gravel			161	168	15. Well grouted? <b>yes</b> With: <input checked="" type="checkbox"/> Neat cement <input type="checkbox"/> Bentonite <input type="checkbox"/> Concrete Depth: From <b>4</b> ft. to <b>18</b> ft.
Sand and Gravel			168	183	16. Nearest source of possible contamination: ft. <input type="checkbox"/> Direction <b>None</b> Type <input type="checkbox"/> Well disinfected upon completion? <input checked="" type="checkbox"/> Yes <input type="checkbox"/> No
Rock			183	189	17. Pump: <input checked="" type="checkbox"/> Not installed
Sand and Gravel			189	232	Manufacturer's name <input type="checkbox"/> Model number <input type="checkbox"/> HP <input type="checkbox"/> Volts <input type="checkbox"/> Length of drop pipe <input type="checkbox"/> ft. capacity <input type="checkbox"/> g.p.m. Type: <input type="checkbox"/> Submersible <input type="checkbox"/> Turbine <input type="checkbox"/> Jet <input type="checkbox"/> Reciprocating <input type="checkbox"/> Centrifugal <input type="checkbox"/> Other
Sand Rock			232	238	
Sand			238	240	
Sand Rock			240	241	
Sand and Gravel (Use a second sheet if needed)			241	245	
18. Elevation:	19. Remarks: <b>Pump installed by someone other than us. BROCK ?</b>		20. Water well contractor's certification: This well was drilled under my jurisdiction and this report is true to the best of my knowledge and belief. <b>Bartell Drilling</b> <b>139</b> Business name License No. Address <b>Winona, Kansas 67764</b> Signed <b>Joyce Bartee</b> Date <b>4/25</b> Authorized representative		

Forward the white, blue and pink copies to the Department of Health and Environment

Form WWC-5