

USE TYPEWRITER OR TYPE
PRINTED PRESS FIRMLY
PRINT CLEARLY.

WATER WELL RECORD
KSA 82a-1201-1215

Kansas Department of Health and
Environment-Division of Environment
(Water well Contractors)
Topeka, Kansas 66620


Fraction SW 1/4 NE 1/4 NE 1/4 Section number #24 Township number T 8 S R 32 E/W

2. Distance and direction from nearest town or city: From Colby, Ks.,
3 1/2 miles South & 11 miles East
Street address at well location if in city:

3. Owner of well: Lyle Saddler
Rt. #3
City, state, zip code: Colby, Kansas

4. Locate with "X" in section below:

Sketch map:

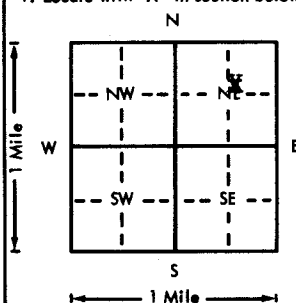

5. Type and color of material

	From	To
Clay & sand streaks	0	140
Clay	140	146
Medium to coarse sand & gravel	146	157
Clay	157	159
Fine to medium sand	159	166
Fine to coarse sand	166	196
Clay	196	197
Medium to coarse sand & sand streaks	197	206
Fine to medium sand & clay streaks	206	218
Medium to coarse sand	218	231
Fine to medium sand & clay streaks	231	235
Medium to coarse sand	235	243
Fine to medium sand & clay streaks	243	247
Medium to coarse sand	247	251
Clay	251	253
Fine to medium sand	253	256
Ochre & sand streaks	256	260
Shale	260	---

(Use a second sheet if needed)

18. Elevation:

19. Remarks:

Topography:
Hill
Slope
☒ Upland
Valley

3659 (TOPO)

6. Bore hole dia. 30 in. Completion date 11-18-75
Well depth 260 ft.
7. Cable tool Rotary Driven Dug
Hollow rod Jetted Bored Reverse rotary
8. Use: Domestic Public supply Industry
Irrigation Air conditioning Stock
Lawn Oil field water Other
9. Casing: Material steel Height: Above or below
Threaded Welded X Surface 12 in.
RMP PVC Weight .188 lbs./ft.
Dia. 16 in. to 150 ft. depth Wall Thickness: inches or
Dia. in. to ft. depth gage No. #7 gauge

10. Screen: Manufacturer's name W. A. Brown
Type regular Dia. 16 in.
Slot/gauze 10% Length 100 ft.
Set between 150 ft. and 250 ft.
10' of cook ft. and 260 ft.
Gravel pack? yes Size range of material 1/4 to 5/8

11. Static water level: 124 ft. below land surface Date 12-2-75

12. Pumping level below land surfaces:
250 ft. after 2 hrs. pumping 1750 g.p.m.
ft. after hrs. pumping g.p.m.
Estimated maximum yield 1750 g.p.m.

13. Water sample submitted: mo./day/yr.
Yes X No Date

14. Well head completion:
Pitless adapter 12 inches above grade

15. Well grouted? yes
With: Neat cement X Bentonite Concrete
Depth: From 0 ft. to 10 ft.

16. Nearest source of possible contamination:
ft. 25 mile direction W-NW Type Farm
Well disinfected upon completion? Yes X No

17. Pump: Not installed
Manufacturer's name Floway
Model number 10-1000HP Volts
Length of drop pipe 249 ft. capacity 550 g.p.m.
Type:
Submersible X Turbine
Jet Reciprocating
Centrifugal Other

20. Water well contractor's certification:
This well was drilled under my jurisdiction and this report
is true to the best of my knowledge and belief.
Western Well & Pump, Inc. 245
Business name License No.
Address P.O. Box 852, Colby, Ks.
Signed Roy F. Senior Date Jan 9
Authorized representative