CORRECTION(S) TO WATER WELL RECORD (WWC-5)

(to rectify lacking or incorrect information)

County: Thomas

Location listed as:	**Location changed to:**
Section-Township-Range: 33 - 8S - 4W	4 - 8S - 33W
Fraction (¼ ¼ ¼): NW SW NE	NE SE NE

Other changes: Initial statements: _____

Changed to: _____

Comments: _____

verification method: written & legal descriptions, position on plat map, and mapping tool & aerial photos on KGS website.

initials: DRL date: 6/12/2006

submitted by: Kansas Geological Survey, Data Resources Library, 1930 Constant Ave., Lawrence, KS 66047-3726
to: Kansas Dept of Health & Environment, Bureau of Water, 1000 SW Jackson, Suite 420, Topeka, KS 66612-1367.

WATER WELL RECORD Form WWC-5 KSA 82a-1212 ID No.

1 LOCATION OF WATER WELL:	Fraction	Section Number	Township Number	Range Number
County: **Thomas**	**NW** ¼ **SW** ¼ **NE** ¼	**33**	T **8** S	R **4** E [W]

Distance and direction from nearest town or city street address of well if located within city?
1.5 miles east of Colby

2 WATER WELL OWNER: **Thomas County Landfill**
RR#, St. Address, Box # : **100 N Court**
City, State, ZIP Code : **Colby, KS 67701**
Board of Agriculture, Division of Water Resources
Application Number: **00313973**

3 LOCATE WELL'S LOCATION WITH AN "X" IN SECTION BOX:

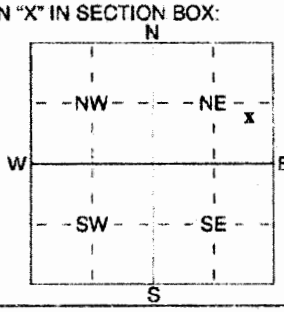

4 DEPTH OF COMPLETED WELL **181.5** ft. ELEVATION:
Depth(s) Groundwater Encountered 1 **156** ft. 2 ..... ft. 3 ..... ft.
WELL'S STATIC WATER LEVEL **156.27** ft. below land surface measured on mo/day/yr **05-10-06**
Pump test data: Well water was ..... ft. after ..... hours pumping ..... gpm
Est. Yield **10** gpm: Well water was ..... ft. after ..... hours pumping ..... gpm
WELL WATER TO BE USED AS: 1 Domestic 3 Feedlot 5 Public water supply 8 Air conditioning 11 Injection well
2 Irrigation 4 Industrial 6 Oil field water supply 9 Dewatering 12 Other (Specify below)
7 Domestic (lawn & garden) [10] Monitoring well **MW-7**

Was a chemical/bacteriological sample submitted to Department? Yes ..... No **x** ; If yes, mo/day/yrs sample was submitted
Water Well Disinfected? Yes No **x**

5 TYPE OF BLANK CASING USED: 1 Steel 3 RMP (SR) 5 Wrought iron 8 Concrete tile
[2] PVC 4 ABS 6 Asbestos-Cement 9 Other (specify below)
7 Fiberglass
CASING JOINTS: Glued ..... Clamped .....
Welded .....
Threaded .....
Blank casing diameter **4** in. to **1851.5** ft., Dia ..... in. to ..... ft., Dia ..... in. to ..... ft.
Casing height above land surface **2.5** in., weight **5.51** lbs./ft. Wall thickness or guage No. **sch 40**

TYPE OF SCREEN OR PERFORATION MATERIAL:
1 Steel 3 Stainless Steel 5 Fiberglass [7] PVC 10 Asbestos-Cement
2 Brass 4 Galvanized Steel 6 Concrete tile 8 RMP (SR) 11 Other (Specify) .....
9 ABS 12 None used (open hole)

SCREEN OR PERFORATION OPENINGS ARE:
1 Continuous slot [3] Mill slot 5 Guazed wrapped 8 Saw cut 11 None (open hole)
2 Louvered shutter 4 Key punched 6 Wire wrapped 9 Drilled holes
7 Torch cut 10 Other (specify) ..... ft.

SCREEN-PERFORATED INTERVALS: From **151.5** ft. to **181.5** ft., From ..... ft. to ..... ft.
From ..... ft. to ..... ft., From ..... ft. to ..... ft.
GRAVEL PACK INTERVALS: From **140.3** ft. to **181.5** ft., From ..... ft. to ..... ft.
From ..... ft. to ..... ft., From ..... ft. to ..... ft.

6 GROUT MATERIAL: 1 Neat cement 2 Cement grout [3] Bentonite 4 Other .....
Grout Intervals: From **143.3** ft. to **146.3** ft., From **146.3** ft. to **0.2** ft., From ..... ft. to ..... ft.

What is the nearest source of possible contamination:
1 Septic tank 4 Lateral lines 7 Pit privy 10 Livestock pens 14 Abandoned water well
2 Sewer lines 5 Cess pool 8 Sewage lagoon 11 Fuel storage 15 Oil well/Gas well
3 Watertight sewer lines 6 Seepage pit 9 Feedyard 12 Fertilizer storage 16 Other (specify below)
13 Insecticide storage **landfill**
Direction from well? **W** How many feet? **75**

FROM	TO	LITHOLOGIC LOG	FROM	TO	PLUGGING INTERVALS
0	1	Topsoil and silt	120	143	silty sand with some sandstone
1	7	silt dark brown, Medium density	143	160	sand fine-medium
7	30	silt light brown, low pasticity	160	173	siltstone with CaCo3 (caliche)
30	40	light tan silt and trace fine sand	173	182	sand with sandstone & CaCo3 (caliche)
40	50	sand with silt			
50	57	sand with silt (sandstone 53-55)			
57	67	sand medium-coarse well rounded			
67	70	sandstone			
70	80	sand with some gravel			
80	82	siltstone w/ CaCo3 interbedded			
82	83	sandstone			
83	90	silty clay and sand intermittent sandstone			
90	112	sand medium			
112	120	sand with sandy clay			

7 CONTRACTOR'S OR LANDOWNER'S CERTIFICATION: This water well was [1] constructed, (2) reconstructed, or (3) plugged under my jurisdiction and was completed on (mo/day/year) **04-13-06** and this record is true to the best of my knowledge and belief. Kansas Water Well Contractor's Licence No **554** This Water Well Record was completed on (mo/day/yr) **05-11-06**
under the business name of **Woofter Pump & Well, Inc.** by (signature) Jay Woofter by af

INSTRUCTIONS: Use typewriter or ball point pen. *PLEASE PRESS FIRMLY* and *PRINT* clearly. Please fill in blanks, underline or circle the correct answers. Send top three copies to Kansas Department of Health and Environment, Bureau of Water, Geology Section, 1000 SW Jackson St., Suite 420, Topeka, Kansas 66612-1367. Telephone 785-296-5522. Send one to WATER WELL OWNER and retain one for your records. Fee of $5.00 for each constructed well.