


1 LOCATION OF WATER WELL: County: <u>Thomas</u>	Fraction <u>NE 1/4 NE 1/4 NW 1/4 E</u>	Section Number <u>9</u>	Township Number <u>8</u>	Range Number <u>33</u> E/W
---	---	----------------------------	-----------------------------	-------------------------------

Distance and direction from nearest town or city street address of well if located within city?

2 WATER WELL OWNER: <u>Shawn Fromholtz</u> RR#, St. Address, Box #: <u>2180 Co Rd. R</u> City, State ZIP Code: <u>Colby, KS 67701</u>	Global Positioning Systems (decimal degrees, min. of 4 digits) Latitude: _____ Longitude: _____ Elevation: _____ Datum: _____ Data Collection Method: _____
--	---

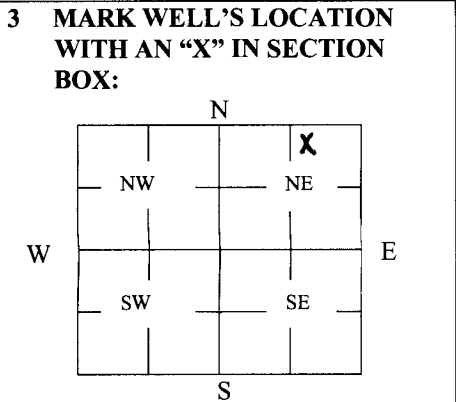

4 DEPTH OF WELL 158' ft.

WELL'S STATIC WATER LEVEL Dry ft

WELL WAS USED AS:

<input checked="" type="radio"/> 1 Domestic	5 Public Water Supply	9 Dewatering
<input type="radio"/> 2 Irrigation	6 Oil Field Water Supply	10 Monitoring
<input type="radio"/> 3 Feedlot	7 Domestic (Lawn & Garden)	11 Injection Well
<input type="radio"/> 4 Industrial	8 Air Conditioning	12 Other _____

Was a chemical/bacteriological sample submitted to Department? Yes _____ No

5 TYPE OF BLANK CASING USED:

<input checked="" type="radio"/> 1 Steel	3 RMP (SR)	5 Wrought	7 Fiberglass	9 Other (Specify below)
<input type="radio"/> 2 PVC	4 ABS	6 Asbestos-Cement	8 Concrete Tile	_____

Blank casing diameter 5" in. Was casing pulled? Yes No _____ in. If yes, how much 3'

Casing height above of below land surface 36" in.

6 GROUT PLUG MATERIAL: 1 Neat cement 2 Cement grout 3 Bentonite 4 Other _____

Grout Plug Intervals: From 158 ft. to 147 ft., From 20 ft. to 4 ft., From 4 to 3 ft.
Bentonite Bentonite Cement Grout Plug

What is the nearest source of possible contamination:

1 Septic tank	6 Seepage pit	11 Fuel Storage	16 Other (specify below)
2 Sewer lines	7 Pit privy	12 Fertilizer storage	_____
3 Watertight sewer lines	8 Sewage lagoon	13 Insecticide storage	_____
4 Lateral lines	9 Feedyard	14 Abandoned water well	Direction from well? <u>SSE</u>
5 Cess pool	<input checked="" type="radio"/> 10 Livestock pens	15 Oil well/Gas well	How many feet? <u>45'</u>

FROM	TO	PLUGGING MATERIALS	FROM	TO	PLUGGING MATERIALS
158	147	Bentonite			
147	20	Clay			
20	4	Bentonite			
4	3	Cement Grout Cap.			
3	0	Compacted Clay + Topsoil			

7 CONTRACTOR'S OR LANDOWNER'S CERTIFICATION: This water well was plugged under my jurisdiction and was completed on (mo/day/year) 4-6-11 and this record is true to the best of my knowledge and belief. Kansas Water Well Contractor's License No. 663. This Water Well Record was completed on (mo/day/year) 4-6-11 under the business name of Brenn Pump & Supply by (signature) [Signature]

INSTRUCTIONS: Use typewriter or ballpoint pen. Please press firmly and print clearly. Please fill in blanks, underline or circle the correct answers. Send top three copies to Kansas Department of Health and Environment, Bureau of Water, Geology Section, 1000 SW Jackson St., Ste. 420, Topeka, Kansas 66612-1367. Telephone: 785/296-5522. Send one to Water Well Owner and retain one for your records. Visit us at <http://www.kdheks.gov/geo/waterwells>.