


WATER WELL PLUGGING RECORD Form WWC-5P KSA 82a-1212 ID NO. 10634

1 LOCATION OF WATER WELL: Fraction SW 1/4 SW 1/4 SW 1/4 NE 1/4 Section Number 34 Township Number T 5 S Range Number 33 E W
 County: Thomas

Street/Rural Address of Well Location; if unknown, distance & direction from nearest town or intersection: If at owner's address, check here
Global Positioning Systems (GPS) information:
 Latitude: 39.39550 (in decimal degrees)
 Longitude: 101.04346 (in decimal degrees)
 Elevation: _____
 Datum: WGS84, NAD83, NAD27
 Collection Method:
 GPS unit (Make/Model: Garmin E-Trex 10)
 Digital Map/Photo, Topographic Map, Land Survey
 Est. Accuracy: <3 m, 3-5 m, 5-15 m, >15 m

2 WATER WELL OWNER: H H Farms Inc.
 RR#, St. Address, Box #: P.O. Box 564
 City, State ZIP Code: Callix KS 67701

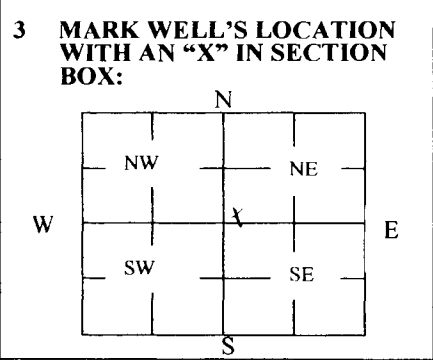

4 DEPTH OF WELL 136 ft.
 WELL'S STATIC WATER LEVEL 168 ft
 WELL WAS USED AS:
 Domestic Public Water Supply Dewatering
 Irrigation Oil Field Water Supply Monitoring
 Feedlot Domestic (Lawn & Garden) Injection Well
 Industrial Air Conditioning Other _____
 Was a chemical/bacteriological sample submitted to Department? Yes No

5 TYPE OF BLANK CASING USED:
 Steel RMP (SR) Wrought Fiberglass Other (Specify below)
 PVC ABS Asbestos-Cement Concrete Tile
 Blank casing diameter 16 in. Was casing pulled? Yes No If yes, how much _____
 Casing height above or below land surface 60 in.

6 GROUT PLUG MATERIAL: Neat cement Cement grout Bentonite Other _____
 Grout Plug Intervals: From 160 ft. to 152 ft., From 11 ft. to 5 ft., From _____ ft. to _____ ft.
 What is the nearest source of possible contamination:
 Septic tank Seepage pit Fuel storage Other (specify below)
 Sewer lines Pit privy Fertilizer storage Field Run-off
 Watertight sewer lines Sewage lagoon Insecticide storage
 Lateral lines Feedyard Abandoned water well
 Cess pool Livestock pens Oil well/Gas well
 Direction from well? S-NW
 How many feet? 50'

FROM	TO	PLUGGING MATERIALS	FROM	TO	PLUGGING MATERIALS
136	160	Washed sand			
160	152	Bentonite			
152	11	Flowable fill			
11	5	Cement Grout			
5	4	Cement Grout (cap)			
4	0	Compacted (clay + lepisol)			

7 CONTRACTOR'S OR LANDOWNER'S CERTIFICATION: This water well was plugged under my jurisdiction and was completed on (mo/day/year) 12-13-15 and this record is true to the best of my knowledge and belief. Kansas Water Well Contractor's License No. 663. This Water Well Record was completed on (mo/day/year) 12-21-15 under the business name of Brynn Pump & Supply by (signature) [Signature]

INSTRUCTIONS: Use typewriter or ballpoint pen. Please press firmly and print clearly. Please fill in blanks, underline or circle the correct answers. Send top three copies to Kansas Department of Health and Environment, Bureau of Water, Geology Section, 1000 SW Jackson St., Ste. 420, Topeka, Kansas 66612-1367. Telephone: 785/296-5524. Send one to Water Well Owner and retain one for your records. Visit us at <http://www.kdheks.gov/waterwell/index.html>.