

County: Thomas Fraction: SE SE NE Sec. 4 T. 8 S R. 33 W

CORRECTION(S) to WATER WELL COMPLETION RECORD Form WWC-5 (to rectify lacking or incorrect information)

Owner: City of Colby

MW 4

If location corrected, was listed as:

Location changed to:

Section-Township-Range: _____

4-8-33W

Fraction (1/4 calls): _____

SE SE NE

Other changes: Initial statements: _____

Changed to: _____

Comments: _____

Verification method: quarter calls, section, township and range given by email from Milco

Environmental

Initials: SH Date: 07-17-2019

Submitted by: ☒ Kansas Geological Survey, Data Resources Library, 1930 Constant Ave., Lawrence, KS 66047-3724

☐ Kansas Dept. of Health & Environment, Bureau of Water, 1000 SW Jackson, Suite 420, Topeka, KS 66612-1367

WATER WELL PLUGGING RECORD

Form WWC-5P

KSA 82a-1212

ID NO.

151-61-01
MW-4

| | | | | | | | | |
|----------------|-------------------------|---|---------|--------|----------|--------|-------|--------|
| 1 | LOCATION OF WATER WELL: | Fraction $\frac{1}{4}$ $\frac{1}{4}$ $\frac{1}{4}$ | Section | Number | Township | Number | Range | Number |
| County: THOMAS | | | | | | | | EW |

Distance and direction from nearest town or city street address of well if located within city?

2 MILES EAST 0.5 MILE SOUTH OF COLBY ON HWY 24

2 WATER WELL OWNER: CITY OF COLBY

RR #, St. Address, Box #:


City, State, ZIP Code

585 N. FRANKLIN
COLBY KS 67701

Board of Agriculture, Division of Water Resources

Application Number:

3 MARK WELL'S LOCATION WITH AN "X" IN SECTION BOX:

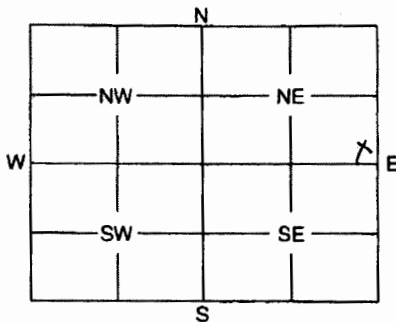

4 DEPTH OF WELL 188.06 ft.

WELL'S STATIC WATER LEVEL NA ft.

WELL WAS USED AS:

- 1 Domestic
- 2 Irrigation
- 3 Feedlot
- 4 Industrial

- 5 Public Water Supply
- 6 Oil Field Water Supply
- 7 Domestic (Lawn & Garden)
- 8 Air Conditioning

- 9 Dewatering
- 10 Monitoring Well MW-4
- 11 Injection Well
- 12 Other

Was a chemical / bacteriological sample submitted to Department? Yes No ☒
If yes, mo/day/yr sample was submittedWater Well Disinfected: Yes No ☒

5 TYPE OF BLANK CASING USED:

- 1 Steel
- 2 PVC
- 3 RMP (SR)
- 4 ABS
- 5 Wrought
- 6 Asbestos-Cement
- 7 Fiberglass
- 8 Concrete Tile
- 9 Other (Specify below)

Blank casing diameter 4 in. Was casing pulled? Yes ☒ No If yes, how much 3 FEET
Casing height above or below land surface 3.2 in.6 GROUT PLUG MATERIAL: 1 Neat cement 2 Cement grout 3 Bentonite 4 Other
Grout Plug Intervals: From 3 ft. to 188.06 ft., From ft. to ft., From to ft.

What is the nearest source of possible contamination:

- 1 Septic tank
- 2 Sewer lines
- 3 Watertight sewer lines
- 4 Lateral lines
- 5 Cess pool
- 6 Seepage pit
- 7 Pit privy
- 8 Sewage lagoon
- 9 Feedyard
- 10 Livestock pens
- 11 Fuel storage
- 12 Fertilizer storage
- 13 Insecticide storage
- 14 Abandoned water well
- 15 Oil well/Gas well
- 16 Other (specify below)
LAND FILL

Direction from well? WEST How many feet? 20'

| FROM | TO | PLUGGING MATERIALS |
|------|--------|--------------------|
| 0 | 3 | NATIVE SOIL |
| 3 | 188.06 | PRESSURIZED GROUT |
| | | |
| | | |
| | | |
| | | |
| | | |

7 CONTRACTOR'S OF LANDOWNER'S CERTIFICATION: This water well was plugged under my jurisdiction and was completed on (mo/day/year) 12-10-08 and this record is true to the best of my knowledge and belief. Kansas Water Well Contractor's License No. 735 This Water Well Record was completed on (mo/day/year) 12-15-08 under the business name of MILCO ENVIRONMENTAL SERVICES
by (signature) [Signature]

INSTRUCTIONS: Use typewriter or ball point pen. Please press firmly and print clearly. Please fill in blanks, underline or circle the correct answers. Send top three copies to Kansas Department of Health and Environment, Bureau of Water, Geology Section, 1000 SW Jackson St., Ste. 420, Topeka, Kansas 66612-1367. Telephone: 785/296-5522. Send one to Water Well Owner and retain one for your records.