

WATER WELL PLUGGING RECORD Form WWC-5P KSA 82a-1212 ID NO.


1 LOCATION OF WATER WELL: Fraction NE 1/4 SE 1/4 NE 1/4 SW 1/4 Section Number 13 Township Number T 8 S Range Number 33 E W
 County: Thomas

Street/Rural Address of Well Location; if unknown, distance & direction from nearest town or intersection: If at owner's address, check here

Global Positioning Systems (GPS) information:
 Latitude: 39.3557 (in decimal degrees)
 Longitude: -100.95289 (in decimal degrees)
 Elevation: _____
 Horizontal Datum: WGS84, NAD83, NAD27
 Collection Method: _____

2 WATER WELL OWNER: H+H Farms
 RR#, St. Address, Box #: 860 Sunset Dr.
 City, State ZIP Code: Colby KS 67701

GPS unit (Make/Model: _____)
 Digital Map/Photo, Topographic Map, Land Survey
 Est. Accuracy: < 3 m, 3-5 m, 5-15 m, > 15 m

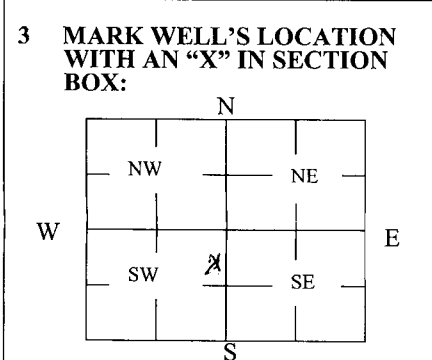

4 DEPTH OF WELL 84 ft.
 WELL'S STATIC WATER LEVEL Dry ft.
 WELL WAS USED AS:
 Domestic Public Water Supply Dewatering
 Irrigation Oil Field Water Supply Monitoring
 Feedlot Domestic (Lawn & Garden) Injection Well
 Industrial Air Conditioning Other _____
 Was a chemical/bacteriological sample submitted to Department? Yes No

5 TYPE OF BLANK CASING USED:

Steel RMP (SR) Wrought Fiberglass Other (Specify below) _____
 PVC ABS Asbestos-Cement Concrete Tile _____

Blank casing diameter 5 in. Was casing pulled? Yes No If yes, how much 48''
 Casing height above or below land surface 48' in.

6 GROUT PLUG MATERIAL: Neat cement Cement grout Bentonite Other _____

Grout Plug Intervals: From 84 ft. to 7 ft., From 7 ft. to 4 ft., From _____ ft. to _____ ft.
Bentonite Cement Grout

What is the nearest source of possible contamination:
 Septic tank Seepage pit Fuel storage Other (specify below) Run-off Farm Field
 Sewer lines Pit privy Fertilizer storage
 Watertight sewer lines Sewage lagoon Insecticide storage
 Lateral lines Feedyard Abandoned water well Direction from well? N
 Cess pool Livestock pens Oil well/Gas well How many feet? 20'

FROM	TO	PLUGGING MATERIALS	FROM	TO	PLUGGING MATERIALS
84	7	Bentonite			
7	4	Cement Grout			
4	0	Compacted Clay Topsoil			

7 CONTRACTOR'S OR LANDOWNER'S CERTIFICATION: This water well was plugged under my jurisdiction and was completed on (mo/day/year) 12-31-21 and this record is true to the best of my knowledge and belief. Kansas Water Well Contractor's License No. 663. This Water Well Record was completed on (mo/day/year) 1-5-22 under the business name of Breen Pump & Supply by (signature) [Signature]