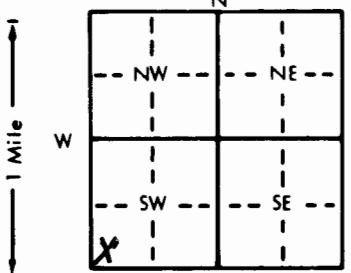


1 LOCATION OF WATER WELL: County: Thomas	Fraction SW $\frac{1}{4}$ SW $\frac{1}{4}$ SW $\frac{1}{4}$	Section Number 30	Township Number T 8 S	Range Number R 33 EW
--	---	-----------------------------	---------------------------------	---------------------------------------

Distance and direction from nearest town or city street address of well if located within city?

4 miles south of Colby, Ks.

2 WATER WELL OWNER: Ron Chase RR#, St. Address, Box #: 1360 1 ST Annex City, State, ZIP Code: Colby, Ks. 67701	Board of Agriculture, Division of Water Resources Application Number:
---	--

3 LOCATE WELL'S LOCATION WITH AN "X" IN SECTION BOX: 	4 DEPTH OF COMPLETED WELL: 280 ft. ELEVATION: Depth(s) Groundwater Encountered 1. ft. 2. ft. 3. ft. WELL'S STATIC WATER LEVEL 160 ft. below land surface measured on mo/day/yr Pump test data: Well water was ft. after hours pumping gpm Est. Yield gpm: Well water was ft. after hours pumping gpm Bore Hole Diameter 8 in. to 280 ft., and in. to ft. WELL WATER TO BE USED AS: 5 Public water supply 8 Air conditioning 11 Injection well 1 Domestic 3 Feedlot 6 Oil field water supply 9 Dewatering 12 Other (Specify below) 2 Irrigation 4 Industrial 7 Lawn and garden only 10 Monitoring well Was a chemical/bacteriological sample submitted to Department? Yes No X If yes, mo/day/yr sample was submitted Water Well Disinfected? Yes X No
--	--

5 TYPE OF BLANK CASING USED: 1 Steel 3 RMP (SR) 5 Wrought iron 8 Concrete tile 2 PVC 4 ABS 6 Asbestos-Cement 9 Other (specify below) Blank casing diameter 4.5 in. to 260 ft., Dia. in. to ft., Dia. in. to ft. Casing height above land surface 24 in., weight 2.38 lbs./ft. Wall thickness or gauge No. 248 TYPE OF SCREEN OR PERFORATION MATERIAL: 1 Steel 3 Stainless steel 5 Fiberglass 7 PVC 10 Asbestos-cement 2 Brass 4 Galvanized steel 6 Concrete tile 8 RMP (SR) 11 Other (specify) SCREEN OR PERFORATION OPENINGS ARE: 1 Continuous slot 3 Mill slot 5 Gauzed wrapped 8 Saw cut 11 None (open hole) 2 Louvered shutter 4 Key punched 6 Wire wrapped 9 Drilled holes 7 Torch cut 10 Other (specify) SCREEN-PERFORATED INTERVALS: From 260 ft. to 280 ft., From ft. to ft. GRAVEL PACK INTERVALS: From 20 ft. to 280 ft., From ft. to ft.	CASING JOINTS: Glued X Clamped Welded Threaded
---	---

6 GROUT MATERIAL: 1 Neat cement 2 Cement grout 3 Bentonite 4 Other Grout intervals: From 0 ft. to 20 ft., From ft. to ft., From ft. to ft. What is the nearest source of possible contamination: 1 Septic tank 4 Lateral lines 7 Pit privy 10 Livestock pens 14 Abandoned water well 2 Sewer lines 5 Cess pool 8 Sewage lagoon 11 Fuel storage 15 Oil well/Gas well 3 Watertight sewer lines 6 Seepage pit 9 Feedyard 12 Fertilizer storage 16 Other (specify below) 13 Insecticide storage Direction from well? 30 How many feet? SW
--

FROM	TO	LITHOLOGIC LOG	FROM	TO	PLUGGING INTERVALS
0	3	Surface	160	164	Med. sand
3	21	Clay	164	166	Clay
21	70	Med. sand	166	168	Caliche / clay streak
70	75	Caliche	168	169	Cemented sand
75	85	Med. to large gravel	169	173	Clay
85	119	Clay & sandstone	173	215	Loose sand(Fine to med.) clay
119	122	Caliche & rocky sand ledge	215	217	Clay & caliche
122	126	Med. gravel	217	235	Med. sand
126	130	Clay	235	238	Clay
130	134	Med. sand	238	240	Fine sand
134	142	Sandy clay	240	245	Clay
142	146	Med. sand	245	255	Med. sand
146	153	Clay	255	270	Clay & sugar sand
153	159	Med. sand	270	275	Med. sand
159	160	Clay	275	280	Ochre & shale

7 CONTRACTOR'S OR LANDOWNER'S CERTIFICATION: This water well was (1) constructed, (2) reconstructed, or (3) plugged under my jurisdiction and was completed on (mo/day/year) 9-11-91 and this record is true to the best of my knowledge and belief. Kansas Water Well Contractor's License No. 394 This Water Well Record was completed on (mo/day/yr) 9-17-91 under the business name of WOOFER PUMP & WELL by (signature) <i>Walter Woofler</i>
--

INSTRUCTIONS: Use typewriter or ball point pen. PLEASE PRESS FIRMLY and PRINT clearly. Please fill in blanks, underline or circle the correct answers. Send top three copies to Kansas Department of Health and Environment, Bureau of Water, Topeka, Kansas 66620-0001. Telephone: 913-296-5545. Send one to WATER WELL OWNER and retain one for your records.