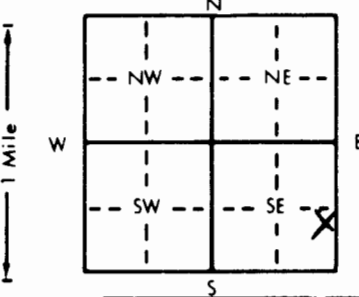


1 LOCATION OF WATER WELL:		Fraction	Section Number	Township Number	Range Number
County: Thomas		NE 1/4 SE 1/4 SE 1/4	12	T 8 S	R 34 EW
Distance and direction from nearest town or city street address of well if located within city?					
1990 S. Range					
2 WATER WELL OWNER: Colby Stop 2 Shop					
RR#, St. Address, Box #: 1990 S. Range					
City, State, ZIP Code: Colby, Ks. 67701					
Board of Agriculture, Division of Water Resources					
MW #3 Application Number:					
3 LOCATE WELL'S LOCATION WITH AN "X" IN SECTION BOX:		4 DEPTH OF COMPLETED WELL: 190 ft. ELEVATION:			
		Depth(s) Groundwater Encountered 1. ft. 2. ft. 3. ft.			
		WELL'S STATIC WATER LEVEL: 170.70 ft. below land surface measured on mo/day/yr			
		Pump test data: Well water was ft. after hours pumping gpm			
		Est. Yield gpm: Well water was ft. after hours pumping gpm			
		Bore Hole Diameter: 8 in. to 190 ft. and in. to ft.			
		WELL WATER TO BE USED AS:			
		5 Public water supply 8 Air conditioning 11 Injection well			
		1 Domestic 3 Feedlot 6 Oil field water supply 9 Dewatering 12 Other (Specify below)			
		2 Irrigation 4 Industrial 7 Lawn and garden only 10 Monitoring well			
		Was a chemical/bacteriological sample submitted to Department? Yes No X			
		If yes, mo/day/yr sample was submitted			
		Water Well Disinfected? Yes No X			
5 TYPE OF BLANK CASING USED:					
1 Steel 3 RMP (SR) 5 Wrought iron 8 Concrete tile CASING JOINTS: Glued Clamped					
2 PVC 4 ABS 6 Asbestos-Cement 9 Other (specify below) Welded					
3 Fiberglass Threaded X					
Blank casing diameter 4 in. to 160 ft. Dia. in. to ft. Dia. in. to ft.					
Casing height above land surface 0 in., weight 2.071 lbs./ft. Wall thickness or gauge No. 237					
TYPE OF SCREEN OR PERFORATION MATERIAL:					
1 Steel 3 Stainless steel 5 Fiberglass 7 PVC 10 Asbestos-cement					
2 Brass 4 Galvanized steel 6 Concrete tile 8 RMP (SR) 11 Other (specify)					
3 None used (open hole)					
SCREEN OR PERFORATION OPENINGS ARE:					
1 Continuous slot 3 Mill slot 5 Gauzed wrapped 8 Saw cut 11 None (open hole)					
2 Louvered shutter 4 Key punched 6 Wire wrapped 9 Drilled holes					
7 Torch cut 10 Other (specify)					
SCREEN-PERFORATED INTERVALS: From 160 ft. to 190 ft. From ft. to ft.					
From ft. to ft. From ft. to ft.					
GRAVEL PACK INTERVALS: From 157 ft. to 190 ft. From ft. to ft.					
From ft. to ft. From ft. to ft.					
6 GROUT MATERIAL: 1 Neat cement 2 Cement grout 3 Bentonite 4 Other					
Grout intervals: From 0 ft. to 2 ft. From 2 ft. to 157 ft. From ft. to ft.					
What is the nearest source of possible contamination:					
1 Septic tank 4 Lateral lines 7 Pit privy 10 Livestock pens 14 Abandoned water well					
2 Sewer lines 5 Cess pool 8 Sewage lagoon 11 Fuel storage 15 Oil well/Gas well					
3 Watertight sewer lines 6 Seepage pit 9 Feedyard 12 Fertilizer storage 16 Other (specify below)					
13 Insecticide storage Removed Fuel Storage					
Direction from well? How many feet?					
FROM TO LITHOLOGIC LOG FROM TO PLUGGING INTERVALS					
0 3 surface 147 155 clay & sand stks					
3 30 loess 155 167 sand & gravel caliche stks					
30 39 caliche clay & cemented sand 167 171 sandy clay					
39 48 sand w/ caliche stks 171 175 caliche & clay & sand stks					
48 73 tight sand w/ caliche 175 182 tight med sand clay stks					
73 75 cemented sand & caliche 182 186 cemented sand & clay					
75 86 sand & gravel w/ clay stks 186 189 caliche & cemented sand					
86 95 tight fine sand & clay 189 190 coarse sand					
95 107 sand-med clay loess					
107 108 caliche					
108 119 med sand & gravel-clay loess					
119 128 tight fine sand-clay loess					
128 130 caliche					
130 136 med sand loose					
136 147 tight sand clay					
7 CONTRACTOR'S OR LANDOWNER'S CERTIFICATION: This water well was (1) constructed, (2) reconstructed, or (3) plugged under my jurisdiction and was completed on (mo/day/year) 7-10-96 and this record is true to the best of my knowledge and belief. Kansas					
Water Well Contractor's License No. 554 This Water Well Record was completed on (mo/day/yr) 7-19-96					
under the business name of Woofter Pump & Well, Inc. by (signature) [Signature]					
INSTRUCTIONS: Use typewriter or ball point pen. PLEASE PRESS FIRMLY and PRINT clearly. Please fill in blanks, underline or circle the correct answers. Send top three copies to Kansas Department of Health and Environment, Bureau of Water, Topeka, Kansas 66620-0001. Telephone: 913-296-5545. Send one to WATER WELL OWNER and retain one for your records.					