

CORRECTION(S) TO WATER WELL RECORD (Form WWC-5)

(to rectify lacking or incorrect information)

LOCATION OF WATER WELL: County: <u>Thomas</u>	Fraction <u>NW</u> $\frac{1}{4}$ <u>NW</u> $\frac{1}{4}$ <u>NE</u> $\frac{1}{4}$ <u>NE</u> $\frac{1}{4}$	Section <u>1</u>	Township T <u>8</u> S	Range R <u>34</u> ☐ E ☒ W
---	---	---------------------	--------------------------	---

Owner: City of Colby

Location was listed as:
Sec. 1 T 7 S R 34 ☐ E ☒ W
Fraction: NW NW NE

Location changed to:
Sec. 1 T 8 S R 34 ☐ E ☒ W
Fraction: NW NW NE NE

Other changes: Initial statements: _____

Changed to: _____

Comments: Constructed record of MW 12

Verification method: Interactive Map and correspondents with MILCO Environmental Services, Inc.

_____ initials: DRL date: 11-17-2016
Submitted by: Kansas Geological Survey, Data Resources Library, 1930 Constant Ave., Lawrence, KS 66047-3726
to: Kansas Dept of Health & Environment, Bureau of Water, 1000 SW Jackson, Suite 420, Topeka, KS 66612-1367.

1 LOCATION OF WATER WELL:		Fraction	Section Number	Township Number	Range Number
County: Thomas		NW ¼ NW ¼ NE ¼	1	T 7 S	R 34 E/W
Distance and direction from nearest town or city street address of well if located within city? Colby Public Power, Colby, Kansas					
2 WATER WELL OWNER:					
RR#, St. Address, Box # : City of Colby 585 N. Franklin			Board of Agriculture, Division of Water Resources		
City, State, ZIP Code : Colby, Kansas 67701			Application Number:		
3 LOCATE WELL'S LOCATION WITH AN "X" IN SECTION BOX:		4 DEPTH OF COMPLETED WELL 140 ft. ELEVATION: 3162.52			
		Depth(s) Groundwater Encountered 1. ft. 2. ft. 3. ft.			
		WELL'S STATIC WATER LEVEL 123.08 ft. below land surface measured on mo/day/yr 1-8-99			
		Pump test data: Well water was NA ft. after hours pumping gpm			
		Est. Yield .. NA .. gpm: Well water was ft. after hours pumping gpm			
		Bore Hole Diameter 12 in. to 140 ft., and in. to ft.			
WELL WATER TO BE USED AS:		5 Public water supply 8 Air conditioning 11 Injection well 1 Domestic 3 Feedlot 6 Oil field water supply 9 Dewatering 12 Other (Specify below) 2 Irrigation 4 Industrial 7 Lawn and garden only 10 Monitoring well			
Was a chemical/bacteriological sample submitted to Department? Yes.....No..... ☒ ; If yes, mo/day/yr sample was submitted		Water Well Disinfected? Yes No ☒			
5 TYPE OF BLANK CASING USED:					
1 Steel 3 RMP (SR)		5 Wrought iron 8 Concrete tile		CASING JOINTS: Glued Clamped	
2 PVC 4 ABS		6 Asbestos-Cement 9 Other (specify below)		Welded	
Blank casing diameter 4 in. to 102 ft, Dia. in. to ft, Dia. in. to ft.		7 Fiberglass		Threaded. ☒	
Casing height above land surface 30.48 in., weight Sch 40 lbs./ft. Wall thickness or gauge No.					
TYPE OF SCREEN OR PERFORATION MATERIAL					
1 Steel 3 Stainless steel 5 Fiberglass 7 PVC 10 Asbestos-cement					
2 Brass 4 Galvanized steel 6 Concrete tile 9 ABS 11 Other (specify)					
SCREEN OR PERFORATION OPENINGS ARE:		12 None used (open hole)			
1 Continuous slot 3 Mill slot 5 Gauzed wrapped 8 Saw cut 11 None (open hole)					
2 Louvered shutter 4 Key punched 6 Wire wrapped 9 Drilled holes					
SCREEN-PERFORATED INTERVALS: From 102 ft. to 137 ft, From ft. to ft.					
GRAVEL PACK INTERVALS: From 99 ft. to 140 ft, From ft. to ft.					
From ft. to ft, From ft. to ft.					
6 GROUT MATERIAL: 1 Neat cement 2 Cement grout 3 Bentonite 4 Other					
Grout Intervals: From 0 ft. to 94 ft, From 94 ft. to 99 ft, From ft. to ft.					
What is the nearest source of possible contamination:					
1 Septic tank 4 Lateral lines 7 Pit privy		10 Livestock pens 14 Abandoned water well			
2 Sewer lines 5 Cess pool 8 Sewage lagoon		11 Fuel storage 15 Oil well/Gas well			
3 Watertight sewer lines 6 Seepage pit 9 Feedyard		16 Other (specify below) Former Tank Basin			
Direction from well? North		How many feet? 250			
FROM	TO	LITHOLOGIC LOG	FROM	TO	PLUGGING INTERVALS
0	7	Clay, Brown			
7	36	Silt, Brown			
36	46	Clay, Red Brown			
46	58	Sand, Brown			
58	64	Sand, Red Brown			
64	73	Sand, Brown			
73	78	Clay, Gray Brown			
78	97	Sand, Brown			
97	111	Sand, Brown			
111	116	Sand,			
116	128	Sand,			
128	140	Sand,			
			MW12, Tag #, Abovegrade		
			Project Name: Colby Public Power		
			GeoCore # 740, KDHE # A6 097 40187		
7 CONTRACTOR'S OR LANDOWNER'S CERTIFICATION: This water well was (1) constructed, (2) reconstructed, or (3) plugged under my jurisdiction and was completed on (mo/day/year) 12/18/98 and this record is true to the best of my knowledge and belief.					
Kansas Water Well Contractor's License No. 554 This Water Well Record was completed on (mo/day/yr) 1/14/99					
under the business name of Woofert Pump & Well by (signature) <i>[Signature]</i>					
INSTRUCTIONS: Use typewriter or ball point pen. PLEASE PRESS FIRMLY and PRINT clearly. Please fill in blanks, underline or circle the correct answers. Send top three copies to Kansas Department of Health and Environment, Bureau of Water, Topeka, Kansas 66620-0001. Telephone: 913-296-5545. Send one to WATER WELL OWNER and retain one for your records.					

OFFICE USE ONLY

T

R


EW

SEC.

1/2

1/2

1/2

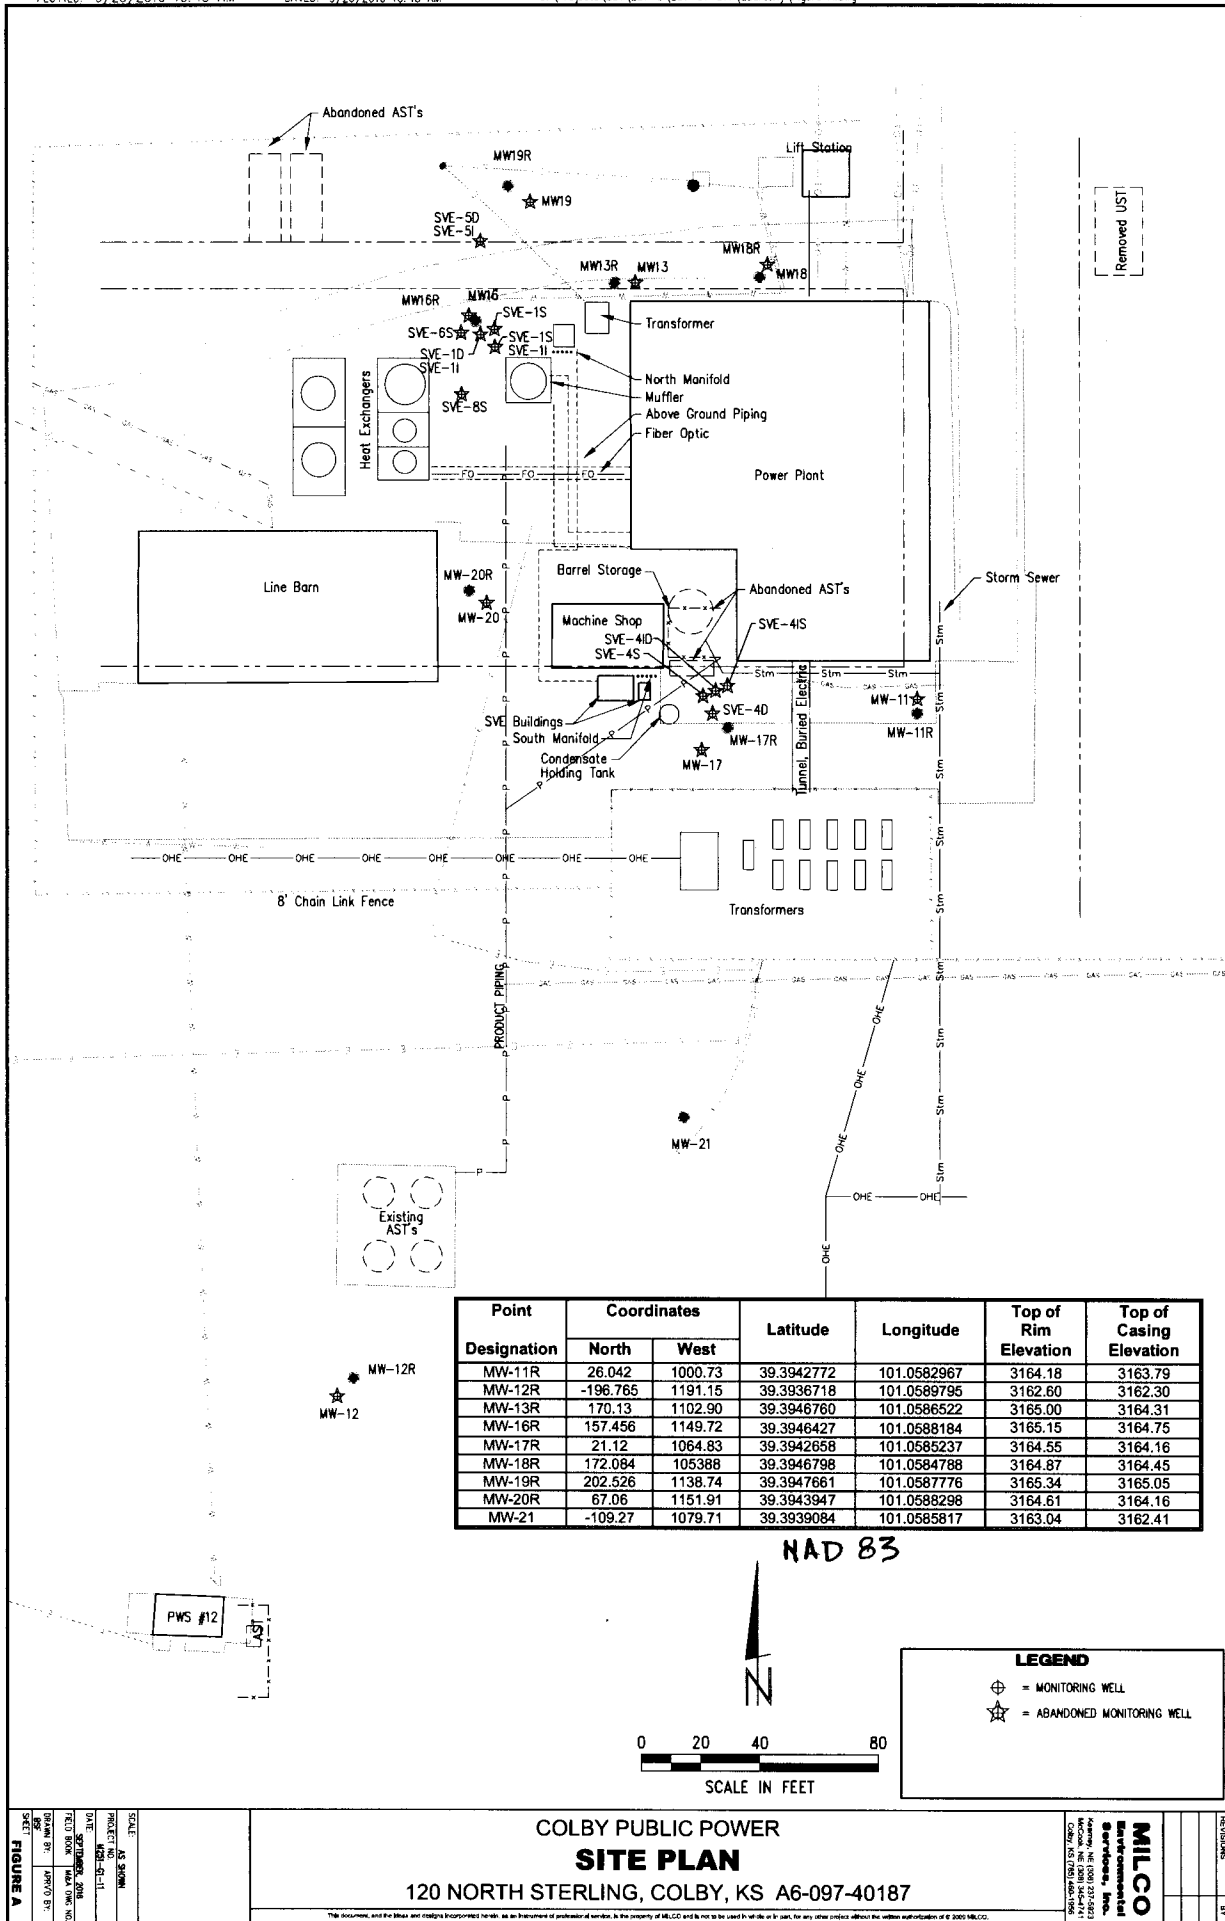

(per surveyor via driller)