

CORRECTION(S) TO WATER WELL RECORD (WWC-5)
(to rectify lacking or incorrect information)

Location listed as:

Section-Township-Range: 5-85-34W

Fraction ($\frac{1}{4}$ $\frac{1}{4}$ $\frac{1}{4}$): NE

County: Thomas

Location changed to:

5-85-34W

NE NE NE

Other changes: Initial statements: _____

Changed to: _____

Comments: _____

verification method: Written & legal descriptions, position on plat map,
and Levant 1:24,000 topo. map.

initials: DRJ date: 4/11/2005

submitted by: Kansas Geological Survey, Data Resources Library, 1930 Constant Ave., Lawrence, KS 66047-3726

to: Kansas Dept of Health & Environment, Bureau of Water, 1000 SW Jackson, Suite 420, Topeka, KS 66612-1367.


1 LOCATION OF WATER WELL: Fraction Lot 10-BL. 1/4 Ac. Est. NE County Thomas Section Number 5 Township Number T 8 S Range Number R 34 EW

Distance and direction from nearest town or city street address of well, if located within city?

4 1/2 West of Colby

2 WATER WELL OWNER: Chaude Belshie Board of Agriculture, Division of Water Resources
RR#, St. Address, Box #: glenn Ave. Est. Colby, KS. 67701
City, State, ZIP Code: Application Number:

3 LOCATE WELL'S LOCATION WITH AN "X" IN SECTION BOX: 4 DEPTH OF COMPLETED WELL 205 ft. ELEVATION:

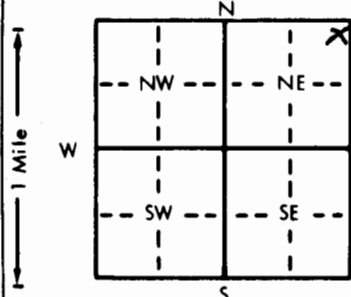

Depth(s) Groundwater Encountered 1. 115 ft. 2. 195 ft. 3. 205 ft.

WELL'S STATIC WATER LEVEL 115 ft. below land surface measured on mo/day/yr



Bore Hole Diameter 7 in. to 205 ft., and 205 in. to 205 ft.

WELL WATER TO BE USED AS: 5 Public water supply 8 Air conditioning 11 Injection well

1 Domestic 3 Feedlot 6 Oil field water supply 9 Dewatering 12 Other (Specify below)

2 Irrigation 4 Industrial 7 Lawn and garden only 10 Observation well

Was a chemical/bacteriological sample submitted to Department? Yes No; If yes, mo/day/yr sample was submitted

Water Well Disinfected? Yes No

5 TYPE OF BLANK CASING USED: 5 Wrought iron 8 Concrete tile CASING JOINTS: Glued Clamped

1 Steel 3 RMP (SR) 6 Asbestos-Cement 9 Other (specify below) Welded

2 PVC 4 ABS 7 Fiberglass Threaded

Blank casing diameter 4 in. to 195 ft., Dia 195 in. to 205 ft., Dia 205 in. to 205 ft.

Casing height above land surface 12 in., weight 140 lbs./ft. Wall thickness or gauge No. 140

TYPE OF SCREEN OR PERFORATION MATERIAL: 7 PVC 10 Asbestos-cement

1 Steel 3 Stainless steel 5 Fiberglass 8 RMP (SR) 11 Other (specify)

2 Brass 4 Galvanized steel 6 Concrete tile 9 ABS 12 None used (open hole)

SCREEN OR PERFORATION OPENINGS ARE: 5 Gauzed wrapped 8 Saw cut 11 None (open hole)

1 Continuous slot 3 Mill slot 6 Wire wrapped 9 Drilled holes

2 Louvered shutter 4 Key punched 7 Torch cut 10 Other (specify)

SCREEN-PERFORATED INTERVALS: From 195 ft. to 205 ft., From 195 ft. to 205 ft., From 195 ft. to 205 ft.


GRAVEL PACK INTERVALS: From 10 ft. to 205 ft., From 10 ft. to 205 ft., From 10 ft. to 205 ft.


6 GROUT MATERIAL: 1 Neat cement 2 Cement grout 3 Bentonite 4 Other

Grout Intervals: From 0 ft. to 12 ft., From 0 ft. to 12 ft., From 0 ft. to 12 ft.

What is the nearest source of possible contamination: 10 Livestock pens 14 Abandoned water well

1 Septic tank 4 Lateral lines 7 Pit privy 11 Fuel storage 15 Oil well/Gas well

2 Sewer lines 5 Cess pool 8 Sewage lagoon 12 Fertilizer storage 16 Other (specify below)

3 Watertight sewer lines 6 Seepage pit 9 Feedyard 13 Insecticide storage None

Direction from well? How many feet?

FROM	TO	LITHOLOGIC LOG	FROM	TO	LITHOLOGIC LOG
0	30	Top soil			
30	45	Sand Gravel			
45	85	Clay & Sandy clay			
85	115	Gravel & sandy clay			
115	170	Gravel			
170	180	Sandstone			
180	195	Gravel			
195	199	Sandstone			
199	205	Gravel			
205	206	ochre & shale			

7 CONTRACTOR'S OR LANDOWNER'S CERTIFICATION: This water well was (1) constructed, (2) reconstructed, or (3) plugged under my jurisdiction and was completed on (mo/day/year) 11-15-83 and this record is true to the best of my knowledge and belief. Kansas

Water Well Contractor's License No. 214 This Water Well Record was completed on (mo/day/yr) 11-28-83

under the business name of Blue Jay Drilling Co Inc by (signature) Walter Gault

INSTRUCTIONS: Use typewriter or ball point pen, PLEASE PRESS FIRMLY and PRINT clearly. Please fill in blanks, underline or circle the correct answers. Send top three copies to Kansas Department of Health and Environment, Division of Environment, Environmental Geology Section, Topeka, KS 66620. Send one to WATER WELL OWNER and retain one for your records.