

CORRECTION(S) TO WATER WELL RECORD (WWC-5)

(to rectify lacking or incorrect information)

County: Thomas

Location listed as:

Section-Township-Range: 5-85-34W

Fraction ($\frac{1}{4}$ $\frac{1}{4}$ $\frac{1}{4}$): NE

Location changed to:

5-85-34W

SE NE NE

Other changes: Initial statements: _____

Changed to: _____

Comments: _____

verification method: Written & legal descriptions, position on plat map,
and Levant 1:24,000 topo. map.

initials: DRL date: 4/11/2005

submitted by: Kansas Geological Survey, Data Resources Library, 1930 Constant Ave., Lawrence, KS 66047-3726

to: Kansas Dept of Health & Environment, Bureau of Water, 1000 SW Jackson, Suite 420, Topeka, KS 66612-1367.


1 LOCATION OF WATER WELL: Fraction Lot 4 Blk. 8 Section Number 5 Township Number 5 Range Number 34
 County: Thomas $\frac{1}{4}$ $\frac{1}{4}$ NE $\frac{1}{4}$ T 5 S R 34 EN

Distance and direction from nearest town or city street address of well if located within city?

4 W Colby Hs

2 WATER WELL OWNER: Kent Doze Colby # 67701
 RR#, St. Address, Box #: Lot 4 Blk 8 County Ave
 City, State, ZIP Code: Board of Agriculture, Division of Water Resources
Application Number:

3 LOCATE WELL'S LOCATION WITH AN "X" IN SECTION BOX:

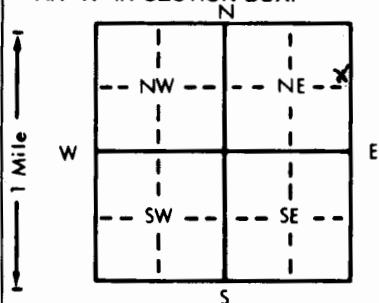

4 DEPTH OF COMPLETED WELL: 215 ft. ELEVATION:

Depth(s) Groundwater Encountered 1. 125 ft. 2. 215 ft. 3. 215 ft.

WELL'S STATIC WATER LEVEL 125 ft. below land surface measured on mo/day/yr




WELL WATER TO BE USED AS: 5 Public water supply 8 Air conditioning 11 Injection well

1 Domestic 3 Feedlot 6 Oil field water supply 9 Dewatering 12 Other (Specify below)

2 Irrigation 4 Industrial 7 Lawn and garden only 10 Observation well

Was a chemical/bacteriological sample submitted to Department? Yes No 2; If yes, mo/day/yr sample was submitted

Water Well Disinfected? Yes No 1

5 TYPE OF BLANK CASING USED:

1 Steel 3 RMP (SR) 5 Wrought iron 8 Concrete tile CASING JOINTS: Glued Clamped

2 PVC 4 ABS 6 Asbestos-Cement 9 Other (specify below) Welded Threaded



TYPE OF SCREEN OR PERFORATION MATERIAL:

1 Steel 3 Stainless steel 5 Fiberglass 7 PVC 10 Asbestos-cement

2 Brass 4 Galvanized steel 6 Concrete tile 8 RMP (SR) 11 Other (specify)

SCREEN OR PERFORATION OPENINGS ARE: 5 Gauzed wrapped 8 Saw cut 11 None (open hole)

1 Continuous slot 3 Mill slot 6 Wire wrapped 9 Drilled holes

2 Louvered shutter 4 Key punched 7 Torch cut 10 Other (specify)



6 GROUT MATERIAL: 1 Neat cement 2 Cement grout 3 Bentonite 4 Other


What is the nearest source of possible contamination:

1 Septic tank 4 Lateral lines 7 Pit privy 10 Livestock pens 14 Abandoned water well

2 Sewer lines 5 Cess pool 8 Sewage lagoon 11 Fuel storage 15 Oil well/Gas well

3 Watertight sewer lines 6 Seepage pit 9 Feedyard 12 Fertilizer storage 16 Other (specify below)

Direction from well? How many feet?

FROM TO LITHOLOGIC LOG FROM TO LITHOLOGIC LOG

0 30 Top soil 0 30 Top soil

30 35 Sand & gravel 30 35 Sand & gravel

35 75 Sandy clay 35 75 Sandy clay

75 110 S. Gravel & sandy clay 75 110 S. Gravel & sandy clay

110 160 Sand & gravel 110 160 Sand & gravel

160 185 Sandy clay & Sand Stone 160 185 Sandy clay & Sand Stone

185 200 Gravel 185 200 Gravel

200 205 Sand Stone 200 205 Sand Stone

205 215 Gravel 205 215 Gravel

215 216 schist & slate 215 216 schist & slate



7 CONTRACTOR'S OR LANDOWNER'S CERTIFICATION: This water well was (1) constructed, (2) reconstructed, or (3) plugged under my jurisdiction and was completed on (mo/day/year) 11-1-83 and this record is true to the best of my knowledge and belief. Kansas Water Well Contractor's License No. 214 This Water Well Record was completed on (mo/day/yr) 11-28-84 under the business name of Blow Jay Drilling Co. Inc by (signature) John Hall

INSTRUCTIONS: Use typewriter or ball point pen, PLEASE PRESS FIRMLY and PRINT clearly. Please fill in blanks, underline or circle the correct answers. Send top three copies to Kansas Department of Health and Environment, Division of Environment, Environmental Geology Section, Topeka, KS 66620. Send one to WATER WELL OWNER and retain one for your records.