


1 LOCATION OF WATER WELL: Fraction NE 1/4 SE 1/4 NW 1/4 NE 1/4 Section Number 5 Township Number T 8 S Range Number 34 E W
 County: Thomas

Street/Rural Address of Well Location; if unknown, distance & direction from nearest town or intersection: If at owner's address, check here
Global Positioning Systems (GPS) information:
 Latitude: 39.392983 (in decimal degrees)
 Longitude: -101.154767 (in decimal degrees)
 Elevation: _____
 Horizontal Datum: WGS84, NAD83, NAD27
 Collection Method: _____
 GPS unit (Make/Model: _____)
 Digital Map/Photo, Topographic Map, Land Survey
 Est. Accuracy: < 3 m, 3-5 m, 5-15 m, > 15 m

2 WATER WELL OWNER: Scott Bondy
 RR#, St. Address, Box #: 1473 Pioneer Dr.
 City, State ZIP Code: Colby, KS 67701

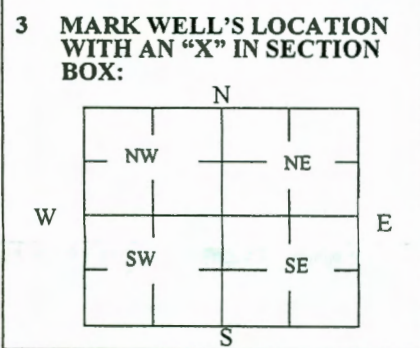

4 DEPTH OF WELL 204 ft.
 WELL'S STATIC WATER LEVEL 148 ft.
 WELL WAS USED AS:
 Domestic Public Water Supply Dewatering
 Irrigation Oil Field Water Supply Monitoring
 Feedlot Domestic (Lawn & Garden) Injection Well
 Industrial Air Conditioning Other _____
 Was a chemical/bacteriological sample submitted to Department? Yes No

5 TYPE OF BLANK CASING USED:
 Steel RMP (SR) Wrought Fiberglass Other (Specify below)
 PVC ABS Asbestos-Cement Concrete Tile
 Blank casing diameter 4" in. Was casing pulled? Yes No If yes, how much _____
 Casing height above or below land surface 60 in. (well at floor.)

6 GROUT PLUG MATERIAL: Neat cement Cement grout Bentonite Other _____
 Grout Plug Intervals: From 135 ft. to 132 ft., From 21 ft. to 7 ft., From 7 ft. to 5 ft.
 What is the nearest source of possible contamination:
 Septic tank Seepage pit Fuel storage Other (specify below)
 Sewer lines Pit privy Fertilizer storage
 Watertight sewer lines Sewage lagoon Insecticide storage
 Lateral lines Feedyard Abandoned water well Direction from well? E
 Cess pool Livestock pens Oil well/Gas well How many feet? 80

FROM	TO	PLUGGING MATERIALS	FROM	TO	PLUGGING MATERIALS
<u>204</u>	<u>135</u>	<u>washed Sand</u>			
<u>135</u>	<u>132</u>	<u>Bentonite</u>			
<u>132</u>	<u>21</u>	<u>Clay</u>			
<u>21</u>	<u>7</u>	<u>Bentonite</u>			
<u>7</u>	<u>5</u>	<u>Cement Grout Cap</u>			
	<u>5'</u>	<u>is well Pit Floor</u>			

7 CONTRACTOR'S OR LANDOWNER'S CERTIFICATION: This water well was plugged under my jurisdiction and was completed on (mo/day/year) 7-6-21 and this record is true to the best of my knowledge and belief. Kansas Water Well Contractor's License No. 663. This Water Well Record was completed on (mo/day/year) 7-10-21 under the business name of Brenn Pump & Supply by (signature) [Signature]