

1 LOCATION OF WATER WELL:	Fraction	Section Number	Township Number	Range Number
County: Thomas	SE 1/4 SE 1/4 NE 1/4	2	T 8 S	R 34 E/W

Distance and direction from nearest town or city street address of well if located within city?

1/2 west 1/2 south of Colby

2 WATER WELL OWNER: Mike Overbay


RR#, St. Address, Box #: Box 27

Board of Agriculture, Division of Water Resources

City, State, ZIP Code: Brewster, Kansas 67732

Application Number:

3 LOCATE WELL'S LOCATION WITH AN "X" IN SECTION BOX:

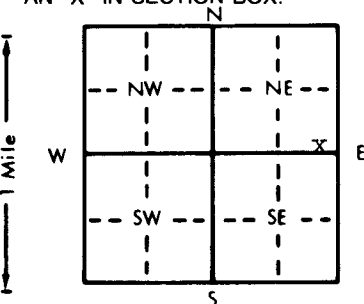

4 DEPTH OF COMPLETED WELL: 250 ft. ELEVATION:

Depth(s) Groundwater Encountered 1. ft. 2. ft. 3. ft.

WELL'S STATIC WATER LEVEL: 145 ft. below land surface measured on mo/day/yr 2-2-84

Pump test data: Well water was ft. after hours pumping gpm

Est. Yield gpm: Well water was not tested ft. after hours pumping gpm

Bore Hole Diameter: 8 in. to 250 ft., and in. to ft.

WELL WATER TO BE USED AS: 5 Public water supply 8 Air conditioning 11 Injection well

1 Domestic 3 Feedlot 6 Oil field water supply 9 Dewatering 12 Other (Specify below)

2 Irrigation 4 Industrial 7 Lawn and garden only 10 Observation well

Was a chemical/bacteriological sample submitted to Department? Yes X X No X; If yes, mo/day/yr sample was submitted Water Well Disinfected? Yes X No

5 TYPE OF BLANK CASING USED:

- 1 Steel  
2 PVC  
3 RMP (SR)  
4 ABS

- 5 Wrought iron  
6 Asbestos-Cement  
7 Fiberglass  
8 Concrete tile  
9 Other (specify below)

CASING JOINTS: Glued X Clamped  
Welded  
Threaded

Blank casing diameter 5 in. to 230 ft., Dia. in. to ft., Dia. in. to ft.

Casing height above land surface: 18 in., weight 18/10 lbs./ft. Wall thickness or gauge No. 1/4"

TYPE OF SCREEN OR PERFORATION MATERIAL:

- 1 Steel  
2 Brass  
3 Stainless steel  
4 Galvanized steel

- 5 Fiberglass  
6 Concrete tile

- 7 PVC  
8 RMP (SR)  
9 ABS  
10 Asbestos-cement  
11 Other (specify)  
12 None used (open hole)

SCREEN OR PERFORATION OPENINGS ARE:

- 1 Continuous slot  
2 Louvered shutter  
3 Mill slot  
4 Key punched

- 5 Gauzed wrapped  
6 Wire wrapped  
7 Torch cut  
8 Saw cut  
9 Drilled holes  
10 Other (specify)  
11 None (open hole)

SCREEN-PERFORATED INTERVALS: From 230 ft. to 250 ft., From ft. to ft.

From ft. to ft., From ft. to ft.

GRAVEL PACK INTERVALS: From 18 ft. to 250 ft., From ft. to ft.

From ft. to ft., From ft. to ft.

6 GROUT MATERIAL:

- 1 Neat cement  
2 Cement grout  
3 Bentonite  
4 Other

Grout intervals: From 4 ft. to 18 ft., From ft. to ft., From ft. to ft.

What is the nearest source of possible contamination:

- 1 Septic tank  
2 Sewer lines  
3 Watertight sewer lines  
4 Lateral lines  
5 Cess pool  
6 Seepage pit  
7 Pit privy  
8 Sewage lagoon  
9 Feedyard  
10 Livestock pens  
11 Fuel storage  
12 Fertilizer storage  
13 Insecticide storage  
14 Abandoned water well  
15 Oil well/Gas well  
16 Other (specify below)  
pasture

Direction from well?

How many feet?

FROM	TO	LITHOLOGIC LOG	FROM	TO	LITHOLOGIC LOG
0	45	top soil			
45	61	sand and clay strips			
61	82	sand rock <del>hard</del> sand and sand strips			
82	96	sand rock hard			
96	166	sand and sand rock strips			
166	184	sand clay			
184	221	sand and sand rock strips			
221	230	sand rock hard			
230	236	sand			
236	240	sand rock hard			
240	248	sand good			
248	250	oker			

7 CONTRACTOR'S OR LANDOWNER'S CERTIFICATION: This water well was (1) constructed, (2) reconstructed, or (3) plugged under my jurisdiction and was completed on (mo/day/year) 2-2-84 and this record is true to the best of my knowledge and belief. Kansas

Water Well Contractor's License No. 139 This Water Well Record was completed on (mo/day/yr) 6-3-84

under the business name of Bartell Drilling

by (signature) Joyce Bartell

INSTRUCTIONS: Use typewriter or ball point pen, PLEASE PRESS FIRMLY and PRINT clearly. Please fill in blanks, underline or circle the correct answers. Send top three copies to Kansas Department of Health and Environment, Division of Environment, Environmental Geology Section, Topeka, KS 66620. Send one to WATER WELL OWNER and retain one for your records.