


LOCATION OF WATER WELL: County: THOMAS Fraction: NC 1/2 NE 1/4 Section Number: 20 Township Number: T 8 S Range Number: R 34 

Distance and direction from nearest town or city street address of well if located within city?

WATER WELL OWNER: RICHARD CALLIHAN
 #, St. Address, Box #: Rt 2 Box 545
 y, State, ZIP Code: COLBY KS 67701

Board of Agriculture, Division of Water Resources
 Application Number:

LOCATE WELL'S LOCATION WITH AN "X" IN SECTION BOX:

DEPTH OF COMPLETED WELL... 101 ft. ELEVATION:

Depth(s) Groundwater Encountered 1. ft. 2. ft. 3. ft.

WELL'S STATIC WATER LEVEL ... 15 ft. below land surface measured on mo/day/yr

Pump test data: Well water was ft. after hours pumping gpm


Est. Yield gpm: Well water was ft. after hours pumping gpm

Bore Hole Diameter..... in. to ft., and in. to ft.

WELL WATER TO BE USED AS: 5 Public water supply 8 Air conditioning 11 Injection well
 ① Domestic 3 Feedlot 6 Oil field water supply 9 Dewatering 12 Other (Specify below)
 2 Irrigation 4 Industrial 7 Lawn and garden only 10 Observation well

Was a chemical/bacteriological sample submitted to Department? Yes.....No.....; If yes, mo/day/yr sample was submitted

Water Well Disinfected? Yes No

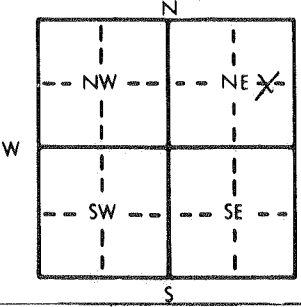

TYPE OF BLANK CASING USED: ① Steel 3 RMP (SR) 5 Wrought iron 8 Concrete tile CASING JOINTS: Glued Clamped
 2 PVC 4 ABS 6 Asbestos-Cement 9 Other (specify below) Welded
 7 Fiberglass Threaded

Blank casing diameter ... 6 in. to ... 101 ft., Dia in. to ft., Dia in. to ft.
 Casing height above land surface..... in., weight lbs./ft. Wall thickness or gauge No.

TYPE OF SCREEN OR PERFORATION MATERIAL: 7 PVC 10 Asbestos-cement
 1 Steel 3 Stainless steel 5 Fiberglass 8 RMP (SR) 11 Other (specify)
 2 Brass 4 Galvanized steel 6 Concrete tile 9 ABS 12 None used (open hole)

SCREEN OR PERFORATION OPENINGS ARE: 5 Gauzed wrapped 8 Saw cut 11 None (open hole)
 1 Continuous slot 3 Mill slot 6 Wire wrapped 9 Drilled holes
 2 Louvered shutter 4 Key punched 7 Torch cut 10 Other (specify)

SCREEN-PERFORATED INTERVALS: From ft. to ft., From ft. to ft.
 GRAVEL PACK INTERVALS: From ft. to ft., From ft. to ft.

GROUT MATERIAL: 1 Neat cement ② Cement grout 3 Bentonite 4 Other
 Grout Intervals: From 14 ft. to 8 ft., From ft. to ft., From ft. to ft.

What is the nearest source of possible contamination:
 1 Septic tank 4 Lateral lines 7 Pit privy 10 Livestock pens 14 Abandoned water well
 2 Sewer lines 5 Cess pool 8 Sewage lagoon 11 Fuel storage 15 Oil well/Gas well
 3 Watertight sewer lines 6 Seepage pit 9 Feedyard 12 Fertilizer storage 16 Other (specify below)
 13 Insecticide storage None

Direction from well? How many feet?

FROM	TO	PLUGGING CRITERIA	LITHOLOGIC LOG	FROM	TO	LITHOLOGIC LOG
101	14	CLEANED SAND				
14	8	CEMENT				
8	0	FILLED IN PIT W/SURFACE CLAY				

CONTRACTOR'S OR LANDOWNER'S CERTIFICATION: This water well was (1) constructed, (2) reconstructed, or ③ plugged under my jurisdiction and was completed on (mo/day/year) 6/10/88 and this record is true to the best of my knowledge and belief. Kansas Water Well Contractor's License No. This Water Well Record was completed on (mo/day/yr) 8/13/88 by (signature) Richard A. Callahan

INSTRUCTIONS: Use typewriter or ball point pen. PLEASE PRESS FIRMLY and PRINT clearly. Please fill in blanks, underline or circle the correct answers. Send top three copies to Kansas Department of Health and Environment, Bureau of Water Protection, Topeka, Kansas 66620-7320, Telephone: 913-862-9360. Send one to WATER WELL OWNER and retain one for your records.