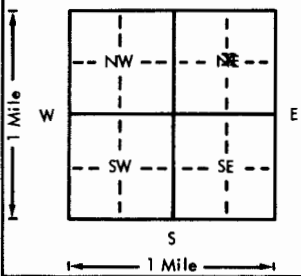


USE TYPEWRITER OR BALL
POINT PEN-PRESS FIRMLY,
PRINT CLEARLY.

WATER WELL RECORD
KSA 820-1201-1215

Kansas Department of Health and
Environment-Division of Environment
(Water well Contractors)
Topeka, Kansas 66620

1. Location of well:		County Thomas	Fraction Center 1/4 1/4 NE 1/4	Section number 32	Township number T 8 S	Range number R 34 E/W
2. Distance and direction from nearest town or city: From Colby; 4 West; 3 1/4 South of I-70; 1/4 West Street address of well location if in city:				3. Owner of well: Smith, Floyd Dr.-Lyle Saddler R.R. or street: City, state, zip code: Colby, Kansas		
4. Locate with "X" in section below:		Sketch map:		6. Bore hole dia. 30 in. Completion date 8-23-76 Well depth 267 ft.		
				7. Cable tool ☐ Rotary ☐ Driven ☐ Dug ☐ Hollow rod ☐ Jetted ☐ Bored ☒ Reverse rotary		
				8. Use: Domestic ☐ Public supply ☐ Industry ☒ Irrigation ☐ Air conditioning ☐ Stock ☐ Lawn ☐ Oil field water ☐ Other ☐		
5. Type and color of material		From	To	9. Casing: Material Steel Height: Above or below XXXX Threaded ☐ Welded ☒ Surface 12 in. RMP ☐ PVC ☐ Weight 188 lbs./ft. Dia 16 in. to 177 ft. depth Wall Thickness: inches or Dia. ☐ in. to ☐ ft. depth gage No. #7		
Clay		0	76	10. Screen: Manufacturer's name Brown		
Sandy Clay		76	105	Type Regular Dia. 16"		
Sand & Gravel & Clay Mix		105	117	Slot/gauze 10% Length 80'		
Clay		117	137	Set between 177 ft. and 257 ft.		
Coarse Sand & Gravel		137	143	10' Cook 257 ft. and 267 ft.		
Clay		143	152	Gravel pack? ☒ Size range of material 1/2 x 5/8 #30 #1		
Coarse Sand & Gravel		152	167	11. Static water level: 178 ft. below land surface Date 8-12-76		
Clay & Sand Streaks		167	175	12. Pumping level below land surfaces: ft. after ☐ hrs. pumping 256 g.p.m. ft. after 2 hrs. pumping 1165 g.p.m. Estimated maximum yield 1165 g.p.m.		
Coarse Sand & Gravel		175	185	13. Water sample submitted: ☐ Yes ☒ No Date ☐		
Clay		185	186	14. Well head completion: 12 inches above grade		
Coarse Sand & Gravel		186	213	15. Well grouted? ☒ Clay		
Clay		213	218	With: Neat cement ☒ Bentonite ☒ Concrete		
Sand & Gravel Cemented Streaks		218	226	Depth: From 0 ft. to 10 ft.		
Clay		226	234	16. Nearest source of possible contamination: 6000 ft. Direction NE Type Farm		
Coarse Sand & Gravel		234	249	Well disinfected upon completion? ☐ Yes ☒ No		
Coarse Sand & Gravel & Layers of Clay		249	256	17. Pump: ☐ Not installed		
Coarse Sand & Gravel		256	260	Manufacturer's name Floway		
Clay		260	262	Model number 056123 HP 100 Volts 480		
Coarse Sand & Gravel		262	265	Length of drop pipe 250 ft. capacity 550 g.p.m.		
Shale		265	267	Type: 11 stage 10" DOH Bowl		
BROCK 265'				☐ Submersible ☒ Turbine		
				☐ Jet ☐ Reciprocating		
				☐ Centrifugal ☐ Other		
				20. Water well contractor's certification: This well was drilled under my jurisdiction and this report is true to the best of my knowledge and belief.		
				Western Well & Pump 245		
				Business name Floway License No. 67701		
				Address Box 852, Colby, KS		
				Signed Darryl Berry Date 9-22-76		
				Authorized representative		
18. Elevation:		19. Remarks:				
Topography: ☐ Hill ☐ Slope ☒ Upland ☐ Valley						

Forward the white, blue and pink copies to the Department of Health and Environment

Form WWC-5