

USE TYPEWRITER, OR BALL
POINT PEN—PRESS FIRMLY,
PRINT CLEARLY.

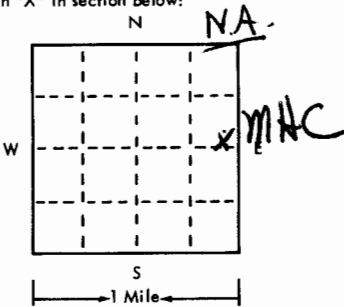
Serial 2-25-77

COLBY SE
WATER WELL RECORD
KSA 82a-1201-1215

ADD

T R EW sec 1/4 1/4 1/4 No.

Kansas State Dept. Of Health
(Water Well Contractors)
Forbes-Bldg. 740
Topeka, Kansas 66620

1 Location of well:	County Thomas	Township name Morgan 2	Fraction SE SE NE	Section number 36	Range number 8
Distance and direction from nearest town or city:			3 Owner of well: Elva F. Rohrbough Rt. 1 Address: Colby, Kansas 67701		
Locate with "X" in section below: 			Sketch map:		
2 Type and color of material			From	To	4 Well depth: 282 ft. Date of completion 4-18-75 Well diameter 8 in.
Top Soil			0	20	5 <input type="checkbox"/> Cable tool <input checked="" type="checkbox"/> Rotary <input type="checkbox"/> Driven <input type="checkbox"/> Dug <input type="checkbox"/> Hollow rod <input type="checkbox"/> Jetted <input type="checkbox"/> Bored <input type="checkbox"/> Reverse rotary
Sand			20	25	6 Use: <input checked="" type="checkbox"/> Domestic <input type="checkbox"/> Public supply <input type="checkbox"/> Industry <input type="checkbox"/> Irrigation <input type="checkbox"/> Air conditioning <input type="checkbox"/> Commercial <input type="checkbox"/> Test well
Clay			25	60	7 Casing: Material Plas Height: above/below Threaded <input type="checkbox"/> Welded <input checked="" type="checkbox"/> Surface 15 in. MAC Diam. Weight _____ lbs./ft. 5 in. to 282 ft. depth Drive shoe? <input type="checkbox"/> Yes <input checked="" type="checkbox"/> No
Sand			60	75	8 Screen: Manufacturer Jet Stream Type RMP Dia. 5 in. Slot/gauze .032 Length 2.5 in. Set between 262 ft. and 282 ft. Fittings: Gravel pack <input checked="" type="checkbox"/> Yes <input type="checkbox"/> No Size range of material 1/8 in.
Sand Clay			75	90	9 Static water level: 132 ft. below land surface Date 4-18-75
Clay			90	95	10 Pumping level below land surfaces: _____ ft. after NA hrs. pumping 145 g.p.m. _____ ft. after _____ hrs. pumping _____ g.p.m. Estimated maximum yield 60 g.p.m.
Sand Clay			95	105	11 Water sample submitted: <input type="checkbox"/> Yes <input checked="" type="checkbox"/> No Date _____
Clay			105	110	12 Well head completion: <input checked="" type="checkbox"/> Pitless adapter <input type="checkbox"/> _____ in. above grade
Sand Rock			110	115	13 Well grouted? <input checked="" type="checkbox"/> Yes <input type="checkbox"/> No <input checked="" type="checkbox"/> Neat cement <input type="checkbox"/> Bentonite <input type="checkbox"/> _____ Depth: From 18 ft. to 4 ft.
Sandy Clay			115	130	14 Nearest source of possible contamination: ft. None Direction _____ Type _____ Well disinfected upon completion? <input checked="" type="checkbox"/> Yes <input type="checkbox"/> No
Sand			130	140	15 Pump: <input type="checkbox"/> Not installed Manufacturer's name Red Jacket Model number 14BC HP 1 Volts 230 Length of drop pipe 214 ft. capacity 45 g.m.p. Type: <input checked="" type="checkbox"/> Submersible <input type="checkbox"/> Turbine <input type="checkbox"/> Jet <input type="checkbox"/> Reciprocating <input type="checkbox"/> Centrifugal <input type="checkbox"/> Other
Sandy Clay			140	147	17 Water well contractor's certification: This well was drilled under my jurisdiction and this report is true to the best of my knowledge and belief. Bartell Drilling 139 Business name _____ License No. _____ Address Winona, Kansas 67764 Signed Robert L. Bartell Date 6/7/75 Authorized representative
Sand			147	162	
Sand Rock			162	165	
Sand			165	172	
Lime Stone			172	174	
16 Remarks: elevation 3213 (Topo) BROOK Topography: <input type="checkbox"/> Hill <input type="checkbox"/> Slope <input checked="" type="checkbox"/> Upland <input type="checkbox"/> Valley					

Forward the white, blue and pink copies to the Kansas State Dept. Of Health.

Form WWC-5

USE TYPEWRITER OR BALL
POINT PEN—PRESS FIRMLY,
PRINT CLEARLY.

WATER WELL RECORD
KSA 82a-1201-1215

T R EW sec 1/4 1/4 1/4 No.

Kansas State Dept. Of Health
(Water Well Contractors)
Forbes-Bldg. 740
Topeka, Kansas 66620

CONT. FROM PAGE 1

1 Location of well:	County Thomas	Township name SE SE NE	Fraction 36	Section number 8	Town number 34	Range number 34
Distance and direction from nearest town or city: Street address of well location if in city:			3 Owner of well: Eva F. Rohrbough Address: Rt. 1 Colby, Kansas 67701			
Locate with "X" in section below: N W E S 1 Mile			Sketch map: 4 Well depth: 282 ft. Date of completion 4/18/75 Well diameter 8 in. 5 <input type="checkbox"/> Cable tool <input checked="" type="checkbox"/> Rotary <input type="checkbox"/> Driven <input type="checkbox"/> Dug <input type="checkbox"/> Hollow rod <input type="checkbox"/> Jetted <input type="checkbox"/> Bored <input type="checkbox"/> Reverse rotary 6 Use: <input checked="" type="checkbox"/> Domestic <input type="checkbox"/> Public supply <input type="checkbox"/> Industry <input type="checkbox"/> Irrigation <input type="checkbox"/> Air conditioning <input type="checkbox"/> Commercial <input type="checkbox"/> Test well <input type="checkbox"/> 7 Casing: Material RMP Height: above/below Threaded <input type="checkbox"/> Welded <input checked="" type="checkbox"/> Surface 15 in. MHC Diam. _____ Weight _____ lbs./ft. _____ 5 in. to 282 ft. depth Drive shoe? <input type="checkbox"/> Yes <input checked="" type="checkbox"/> No _____ in. to _____ ft. depth 8 Screen: Manufacturer Jet Stream Type RMP Dia. 5 in. Slot/gauze 032 Length 2.5 in. Set between 262 ft. and 282 ft. Fittings: Gravel pack <input checked="" type="checkbox"/> Yes <input type="checkbox"/> No Size range of material 1/8 in 9 Static water level: 132 ft. below land surface Date 4/18/75 10 Pumping level below land surfaces: _____ ft. after _____ hrs. pumping 15 g.p.m. _____ ft. after _____ hrs. pumping _____ g.p.m. Estimated maximum yield 60 g.p.m. 11 Water sample submitted: <input type="checkbox"/> Yes <input checked="" type="checkbox"/> No Date _____ 12 Well head completion: <input checked="" type="checkbox"/> Pitless adapter <input type="checkbox"/> Inches above grade 20 in. 13 Well grouted? <input checked="" type="checkbox"/> Yes <input type="checkbox"/> No <input checked="" type="checkbox"/> Neat cement <input type="checkbox"/> Bentonite <input type="checkbox"/> Depth: From 18 ft. to 4 ft. 14 Nearest source of possible contamination: ft. None Direction _____ Type _____ Well disinfected upon completion? <input checked="" type="checkbox"/> Yes <input type="checkbox"/> No 15 Pump: <input type="checkbox"/> Not installed Manufacturer's name Red Jacket Model number 14BC HP 1 Volts 230 Length of drop pipe 214 ft. capacity 15 g.m.p. Type: <input checked="" type="checkbox"/> Submersible <input type="checkbox"/> Turbine <input type="checkbox"/> Jet <input type="checkbox"/> Reciprocating <input type="checkbox"/> Centrifugal <input type="checkbox"/> Other 16 Remarks: elevation Topography: <input type="checkbox"/> Hill <input type="checkbox"/> Slope <input checked="" type="checkbox"/> Upland <input type="checkbox"/> Valley 17 Water well contractor's certification: This well was drilled under my jurisdiction and this report is true to the best of my knowledge and belief. Bartell Drilling 139 Business name _____ License No. _____ Address: Winona, Kansas 67764 Signed Robert L. Bartell Date 6/17/75 Authorized representative			

Forward the white, blue and pink copies to the Kansas State Dept. Of Health.

Form WWC-5