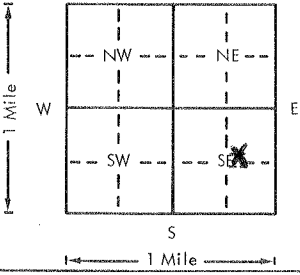


USE TYPEWRITER OR BALL
POINT PEN-PRESS FIRMLY,
PRINT CLEARLY.

WATER WELL RECORD
KSA 82a-1201-1215

Kansas Department of Health and
Environment-Division of Environment
(Water well Contractors)
Topeka, Kansas 66620

1. Location of well:	County Thomas	Fraction SW 1/4 NE 1/4 SE 1/4	Section number 2	Township number T 8 S R 35	Range number 35
2. Distance and direction from nearest town or city: 8 Miles West of Colby Street address of well location if in city:			3. Owner of well Thomas L. Hillary R.R. or street: 110 N. Range City, state, zip code: Colby, Kansas 67701		
4. Locate with "X" in section below: N W E S 1 Mile Sketch map: 			6. Bore hole dia. 8 in. Completion date 5/30/77 Well depth 225 ft.		
5. Type and color of material			7. <input checked="" type="checkbox"/> Cable tool <input checked="" type="checkbox"/> Rotary <input type="checkbox"/> Driven <input type="checkbox"/> Dug <input type="checkbox"/> Hollow rod <input type="checkbox"/> Jetted <input type="checkbox"/> Bored <input type="checkbox"/> Reverse rotary		
			8. Use: <input checked="" type="checkbox"/> Domestic <input type="checkbox"/> Public supply <input type="checkbox"/> Industry <input type="checkbox"/> Irrigation <input type="checkbox"/> Air conditioning <input type="checkbox"/> Stock <input type="checkbox"/> Lawn <input type="checkbox"/> Oil field water <input type="checkbox"/> Other		
			9. Casing: Material pist Height: Above or below Threaded <input type="checkbox"/> Welded <input checked="" type="checkbox"/> Surface 75 in. RMP <input checked="" type="checkbox"/> PVC <input type="checkbox"/> Weight <input type="checkbox"/> lbs./ft. Dia. 5 in. to 225 ft. depth Wall Thickness: inches or Dia. <input type="checkbox"/> in. to <input type="checkbox"/> ft. depth gage No. 250		
			10. Screen: Manufacturer's name J&L Type RMP Dia. 5 Slot/gauze .032 Length 20' Set between 205 ft. and 225 ft. Gravel pack? yes Size range of material 1/8"		
			11. Static water level: 155 ft. below land surface Date 5/30/77		
			12. Pumping level below land surfaces: ft. after no a hrs. pumping <input type="checkbox"/> g.p.m. ft. after <input type="checkbox"/> hrs. pumping <input type="checkbox"/> g.p.m. Estimated maximum yield <input type="checkbox"/> g.p.m.		
			13. Water sample submitted: yes No <input type="checkbox"/> Date 5/30/77		
			14. Well head completion: <input checked="" type="checkbox"/> Pitless adapter 20 inches above grade		
			15. Well grouted? yes With: <input checked="" type="checkbox"/> Neat cement <input type="checkbox"/> Bentonite <input type="checkbox"/> Concrete Depth: From 4 ft. to 18 ft.		
			16. Nearest source of possible contamination: ft. <input type="checkbox"/> Direction n.a. Type <input type="checkbox"/> Well disinfected upon completion? <input checked="" type="checkbox"/> Yes <input type="checkbox"/> No		
			17. Pump: <input checked="" type="checkbox"/> Not installed Manufacturer's name <input type="checkbox"/> Model number <input type="checkbox"/> HP <input type="checkbox"/> Volts <input type="checkbox"/> Length of drop pipe <input type="checkbox"/> ft. capacity <input type="checkbox"/> g.p.m. Type: <input type="checkbox"/> Submersible <input type="checkbox"/> Turbine <input type="checkbox"/> Jet <input type="checkbox"/> Reciprocating <input type="checkbox"/> Centrifugal <input type="checkbox"/> Other		
(Use a second sheet if needed)					
18. Elevation: Topography: <input type="checkbox"/> Hill <input checked="" type="checkbox"/> Slope <input type="checkbox"/> Upland <input type="checkbox"/> Valley	19. Remarks: BROCK 223		20. Water well contractor's certification: This well was drilled under my jurisdiction and this report is true to the best of my knowledge and belief. Bartell Drilling 139 Business name License No. Address Winona, Kansas 67764 Signed Joyce Bartell Date 7/7/77 Authorized representative		

Forward the white, blue and pink copies to the Department of Health and Environment

Form WWC-5