

LOCATION OF WATER WELL:	Fraction	Section Number	Township Number	Range Number
County: <u>Thomas</u>	<u>SW</u> $\frac{1}{4}$ <u>NE</u> $\frac{1}{4}$ <u>SW</u> $\frac{1}{4}$	<u>2</u>	T <u>8</u> S	R <u>35</u> E/W

distance and direction from nearest town or city street address of well if located within city?

Levant

WATER WELL OWNER: Jack D. Weed


RR#, St. Address, Box # : H.C.1 Box 4

City, State, ZIP Code : Levant, KS 67743

Board of Agriculture, Division of Water Resources

Application Number: \_\_\_\_\_

LOCATE WELL'S LOCATION WITH AN "X" IN SECTION BOX: 4 DEPTH OF COMPLETED WELL: 127 ft. ELEVATION: 3200

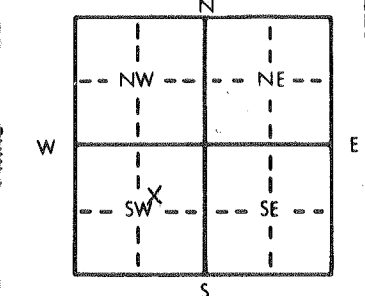

Depth(s) Groundwater Encountered 1. .... ft. 2. .... ft. 3. .... ft.

WELL'S STATIC WATER LEVEL ..... ft. below land surface measured on mo/day/yr .....

Pump test data: Well water was ..... ft. after ..... hours pumping ..... gpm

Est. Yield ..... gpm: Well water was ..... ft. after ..... hours pumping ..... gpm

Bore Hole Diameter, ..... in. to ..... ft., and, ..... in. to ..... ft.

WELL WATER TO BE USED AS:

5 Public water supply	8 Air conditioning	11 Injection well		
① Domestic	3 Feedlot	6 Oil field water supply	9 Dewatering	12 Other (Specify below)
2 Irrigation	4 Industrial	7 Lawn and garden only	10 Observation well	

Was a chemical/bacteriological sample submitted to Department? Yes.....No.....; If yes, mo/day/yr sample was submitted

Water Well Disinfected? Yes No


TYPE OF BLANK CASING USED:		5 Wrought iron	8 Concrete tile	CASING JOINTS: Glued . . . . . Clamped . . . . .
① Steel	3 RMP (SR)	6 Asbestos-Cement	9 Other (specify below)	Welded . . . . .
2 PVC	4 ABS	7 Fiberglass		Threaded. <input checked="" type="checkbox"/> . . . . .

Blank casing diameter . . . . . in. to . . . . . ft., Dia . . . . . in. to . . . . . ft., Dia . . . . . in. to . . . . . ft.  
Casing height above land surface . . . . . in., weight . . . . . lbs./ft. Wall thickness or gauge No. . . . .

TYPE OF SCREEN OR PERFORATION MATERIAL:

<input checked="" type="checkbox"/> Steel	<input type="checkbox"/> 3 Stainless steel	<input type="checkbox"/> 5 Fiberglass	<input type="checkbox"/> 7 PVC	<input checked="" type="checkbox"/> 10 Asbestos-cement
<input type="checkbox"/> 2 Brass	<input checked="" type="checkbox"/> 4 Galvanized steel	<input type="checkbox"/> 6 Concrete tile	<input type="checkbox"/> 8 RMP (SR)	<input type="checkbox"/> 11 Other (specify) .....
			<input type="checkbox"/> 9 ABS	<input type="checkbox"/> 12 None used (open hole)

SCREEN OR PERFORATION OPENINGS ARE:

1 Continuous slot	 Mill slot	5 Gauzed wrapped	8 Saw cut	11 None (open hole)
2 Louvered shutter	4 Key punched	6 Wire wrapped	9 Drilled holes	
		7 Torch cut	10 Other (specify) .....	

SCREEN-PERFORATED INTERVALS:	From . . . . .	ft. to . . . . .	ft., From . . . . .	ft. to . . . . .	ft.
	From . . . . .	ft. to . . . . .	ft., From . . . . .	ft. to . . . . .	ft.
GRAVEL PACK INTERVALS:	From . . . . .	ft. to . . . . .	ft., From . . . . .	ft. to . . . . .	ft.
	From . . . . .	ft. to . . . . .	ft., From . . . . .	ft. to . . . . .	ft.

GROUT MATERIAL:      1 Neat cement              2 Cement grout              3 Bentonite              4 Other .....

Grout Intervals:    From ..... ft. to ..... ft.,    From ..... ft. to ..... ft.,    From ..... ft. to ..... ft.

What is the nearest source of possible contamination:

1 Septic tank	4 Lateral lines	7 Pit privy	10 Livestock pens	14 Abandoned water well
2 Sewer lines	5 Cess pool	8 Sewage lagoon	11 Fuel storage	15 Oil well/Gas well
3 Watertight sewer lines	6 Seepage pit	9 Feedyard	12 Fertilizer storage	16 Other (specify below)
			13 Insecticide storage	.....

Direction from well? \_\_\_\_\_ How many feet? 100 ft

[illegible]

CONTRACTOR'S OR LANDOWNER'S CERTIFICATION: This water well was (1) constructed, (2) reconstructed, or (3) plugged under my jurisdiction and was completed on (mo/day/year) 3-13-88 and this record is true to the best of my knowledge and belief. Kansas Water Well Contractor's License No. \_\_\_\_\_ This Water Well Record was completed on (mo/day/yr) 4-5-88 under the business name of \_\_\_\_\_ by (signature) Jack Ford

INSTRUCTIONS: Use typewriter or ball point pen. PLEASE PRESS FIRMLY and PRINT clearly. Please fill in blanks, underline or circle the correct answers. Send top three copies to Kansas Department of Health and Environment, Bureau of Water Protection, Topeka, Kansas 66620-7320, Telephone: 913-862-9360. Send one to WATER WELL OWNER and retain one for your records.