

1 LOCATION OF WATER WELL:	Fraction	Section Number	Township Number	Range Number
County: <u>Thomas</u>	<u>SE 1/4 SE 1/4 SW 1/4</u>	<u>2</u>	<u>T 8 S</u>	<u>R 35 E/W</u>

Distance and direction from nearest town or city street address of well if located within city?

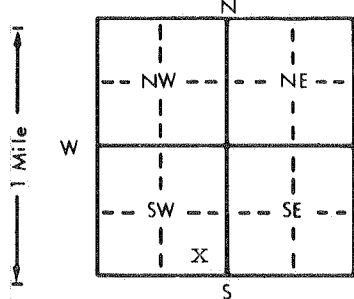
In Leva nt Ks

2 WATER WELL OWNER: Tom Hillery
 RR#, St. Address, Box # : Levant, Ks 67743
 City, State, ZIP Code :

Board of Agriculture, Division of Water Resources

Application Number:

3 LOCATE WELL'S LOCATION WITH AN "X" IN SECTION BOX:

4 DEPTH OF COMPLETED WELL... 210 ft. ELEVATION:

Depth(s) Groundwater Encountered 1. ft. 2. ft. 3. ft.

WELL'S STATIC WATER LEVEL 175 .. ft. below land surface measured on mo/day/yr 3-19-91

Pump test data: Well water was ft. after hours pumping gpm

Est. Yield gpm: Well water was not tested ft. after hours pumping gpmBore Hole Diameter. .8 in. to 2.10 ft., and in. to ft.

WELL WATER TO BE USED AS: 5 Public water supply 8 Air conditioning 11 Injection well

1 Domestic 3 Feedlot 6 Oil field water supply 9 Dewatering 12 Other (Specify below)

2 Irrigation 4 Industrial 7 Lawn and garden only 10 Monitoring well

Was a chemical/bacteriological sample submitted to Department? Yes No X; If yes, mo/day/yr sample was sub-mitted Water Well Disinfected? Yes X No

5 TYPE OF BLANK CASING USED:

- 1 Steel 3 RMP (SR)
 2 PVC 4 ABS

5 Wrought iron

8 Concrete tile

CASING JOINTS: Glued X Clamped

6 Asbestos-Cement

9 Other (specify below)

Welded

7 Fiberglass

Threaded

Blank casing diameter 5 in. to 1.90 ft., Dia in. to ft., Dia in. to ft.Casing height above land surface 18 in., weight 1.8/1.0 lbs./ft. Wall thickness or gauge No. 1/4

TYPE OF SCREEN OR PERFORATION MATERIAL:

- 1 Steel 3 Stainless steel
 2 Brass 4 Galvanized steel

5 Fiberglass

7 PVC

10 Asbestos-cement

6 Concrete tile

8 RMP (SR)

11 Other (specify)

9 ABS

12 None used (open hole)

SCREEN OR PERFORATION OPENINGS ARE:

- 1 Continuous slot 3 Mill slot
 2 Louvered shutter 4 Key punched

5 Gauzed wrapped

8 Saw cut

11 None (open hole)

6 Wire wrapped

9 Drilled holes

7 Torch cut

10 Other (specify)

SCREEN-PERFORATED INTERVALS: From 1.90 ft. to 2.10 ft., From ft. to ft.

From ft. to ft., From ft. to ft.

GRAVEL PACK INTERVALS: From 18 ft. to 2.10 ft., From ft. to ft.

From ft. to ft., From ft. to ft.

6 GROUT MATERIAL: 1 Neat cement 2 Cement grout 3 Bentonite 4 Other

Grout intervals: From 4 ft. to 18 ft., From ft. to ft., From ft. to ft.

What is the nearest source of possible contamination:

- 1 Septic tank 4 Lateral lines
 2 Sewer lines 5 Cess pool
 3 Watertight sewer lines 6 Seepage pit

- 7 Pit privy
 8 Sewage lagoon
 9 Feedyard

- 10 Livestock pens 14 Abandoned water well
 11 Fuel storage 15 Oil well/Gas well
 12 Fertilizer storage 16 Other (specify below)
 13 Insecticide storage

Direction from well?

SouthHow many feet? 100

FROM	TO	LITHOLOGIC LOG	FROM	TO	PLUGGING INTERVALS
0	45	Top soil			
45	49	Sandy clay			
49	53	Sand rock			
53	61	Sandy clay			
61	111	Sand and sand rock strips			
111	120	Sand rock			
120	126	Sand			
126	154	sand rock and clay strips			
154	183	Sand Good			
183	207	Sand and sand rock strips			
207	210	Oker and shale			

7 CONTRACTOR'S OR LANDOWNER'S CERTIFICATION: This water well was (1) constructed, (2) reconstructed, or (3) plugged under my jurisdiction and was completed on (mo/day/yr) 3-19-91 and this record is true to the best of my knowledge and belief. Kansas Water Well Contractor's License No. 139 This Water Well Record was completed on (mo/day/yr) 6-24-91 under the business name of Bartell Drilling by (signature) Boye Bartell

INSTRUCTIONS: Use typewriter or ball point pen. PLEASE PRESS FIRMLY and PRINT clearly. Please fill in blanks, underline or circle the correct answers. Send top three copies to Kansas Department of Health and Environment, Bureau of Water Protection, Topeka, Kansas 66620-7320. Telephone: 913-296-5514. Send one to WATER WELL OWNER and retain one for your records.