

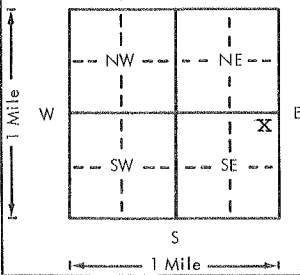
USE TYPEWRITER OR BALL
POINT PEN-PRESS FIRMLY,
PRINT CLEARLY.

WATER WELL RECORD
KSA 82a-1201-1215

Kansas Department of Health and
Environment-Division of Environment
(Water well Contractors)
Topeka, Kansas 66620

#2 Job #186-77-C-36-8-35

DAA

1. Location of well:		County Thomas	Fraction NE 1/4 NE 1/4 SE 1/4	Section number 36	Township number T 8 S R 35	Range number NE/W
2. Distance and direction from nearest town or city: 1 1/2 E Street address of well location if in city:			3. Owner of well: Ken Frahm R.R. or street: City, state, zip code: Colby, Kansas			
4. Locate with "X" in section below: Sketch map: 			6. Bore hole dia. 30 in. Completion date 5-20-77 Well depth 261 ft.			
5. Type and color of material			7. <input type="checkbox"/> Cable tool <input type="checkbox"/> Rotary <input type="checkbox"/> Driven <input type="checkbox"/> Dug <input type="checkbox"/> Hollow rod <input type="checkbox"/> Jetted <input type="checkbox"/> Bored <input checked="" type="checkbox"/> Reverse rotary			
			8. Use: <input checked="" type="checkbox"/> Domestic <input type="checkbox"/> Public supply <input type="checkbox"/> Industry <input checked="" type="checkbox"/> Irrigation <input type="checkbox"/> Air conditioning <input type="checkbox"/> Stock <input type="checkbox"/> Lawn <input type="checkbox"/> Oil field water <input type="checkbox"/> Other			
			9. Casing: Material Steel Height: Above or below Threaded <input type="checkbox"/> Welded <input checked="" type="checkbox"/> Surface 12 in. RMP <input type="checkbox"/> PVC <input type="checkbox"/> Weight .188 lbs./ft. Dia. 16 in. to 19 1/2 ft. depth Wall thickness: inches or Dia. <input type="checkbox"/> in. to <input type="checkbox"/> ft. depth gage No. #7			
			10. Screen: Manufacturer's name Brown Type Bridge Dia. 16" Slot/gauze 10% Length 60' Set between 19 1/2 ft. and 251 ft. 10 Johnson ft. and 261 ft. Gravel pack? <input checked="" type="checkbox"/> Size range of material: 1/2 x 5/8			
			11. Static water level: 180 ft. below land surface Date 6-9-77 mo./day/yr.			
Coa. Sand, Clay, Sandstone Streaks			From	To	12. Pumping level below land surfaces: 215 ft. after 2 hrs. pumping 1902 g.p.m. 1902 g.p.m. Estimated maximum yield 1902 g.p.m.	
Coarse Sand, Med. Gravel, Sandstone, Clay St.			160	180	13. Water sample submitted: mo./day/yr. <input type="checkbox"/> Yes <input checked="" type="checkbox"/> No Date	
Coa. Sand, Med. Gravel, Clay Streaks			180	202	14. Well head completion: <input type="checkbox"/> Pitless adapter 12 inches above grade	
Clay, Sand Streaks			202	210	15. Well grouted? <input checked="" type="checkbox"/> With: <input type="checkbox"/> Neat cement <input checked="" type="checkbox"/> Bentonite <input checked="" type="checkbox"/> Concrete Depth: From 0 ft. to 10 ft.	
Coa. Sand, Med. Gravel, Sandstone Streaks			210	224	16. Nearest source of possible contamination: ft. 6000 Direction SE Type House Well disinfected upon completion? <input type="checkbox"/> Yes <input checked="" type="checkbox"/> No	
Coarse Sand, Med. Gravel			224	259	17. Pump: <input type="checkbox"/> Not installed Manufacturer's name Floway Model number 85370 HP 100 Volts 480 Length of drop pipe 250 ft. capacity 600 g.p.m. Type: <input type="checkbox"/> Submersible <input checked="" type="checkbox"/> Turbine <input type="checkbox"/> Jet <input type="checkbox"/> Reciprocating <input type="checkbox"/> Centrifugal <input type="checkbox"/> Other	
Ochre, Shale			259	261	20. Water well contractor's certification: This well was drilled under my jurisdiction and this report is true to the best of my knowledge and belief. Western Well & Pump 245 Business name License No. Address Box 852 Colby, KS 67701 Signed Dale Berry Date 6/21 Authorized representative	
18. Elevation:			19. Remarks: BRUCK 259' 3281 (TOPO)			
Topography: <input type="checkbox"/> Hill <input type="checkbox"/> Slope <input checked="" type="checkbox"/> Upland <input type="checkbox"/> Valley						

Forward the white, blue and pink copies to the Department of Health and Environment

Form WWC-5