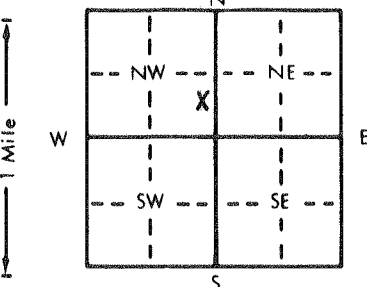


1 LOCATION OF WATER WELL:		Fraction	Section Number	Township Number	Range Number
County: <u>Thomas</u>		<u>SE 1/4 SE 1/4 NW 1/4</u>	<u>6</u>	<u>T 8 S</u>	<u>R 35 E</u>
Distance and direction from nearest town or city street address of well if located within city?					
2 WATER WELL OWNER: <u>Levine - Fricke & A.R.P.</u>					
RR#, St. Address, Box # : <u>401 Washington Str.</u>			Board of Agriculture, Division of Water Resources		
City, State, ZIP Code : <u>Algonquin, Illinois 60102-2650</u>			Application Number:		
3 LOCATE WELL'S LOCATION WITH AN "X" IN SECTION BOX:		4 DEPTH OF COMPLETED WELL: <u>58</u> ft. ELEVATION:			
		Depth(s) Groundwater Encountered 1. ft. 2. ft. 3. ft.			
		WELL'S STATIC WATER LEVEL <u>0</u> ft. below land surface measured on mo/day/yr			
		Pump test data: Well water was ft. after hours pumping gpm			
		Est. Yield gpm: Well water was ft. after hours pumping gpm			
		Bore Hole Diameter <u>8</u> in. to ft., and in. to ft.			
		WELL WATER TO BE USED AS:			
		5 Public water supply 8 Air conditioning 11 Injection well			
		1 Domestic 3 Feedlot 6 Oil field water supply 9 Dewatering 12 Other (Specify below)			
		2 Irrigation 4 Industrial 7 Lawn and garden only <u>10 Monitoring well</u>			
		Was a chemical/bacteriological sample submitted to Department? Yes.....No <u>X</u>; If yes, mo/day/yr sample was submitted			
		Water Well Disinfected? Yes No			
5 TYPE OF BLANK CASING USED:					
1 Steel 3 RMP (SR) 5 Wrought iron 8 Concrete tile CASING JOINTS: Glued Clamped					
<u>2 PVC</u> 4 ABS 7 Fiberglass 9 Other (specify below) Welded					
<u>Threaded</u>					
Blank casing diameter <u>2</u> in. to ft., Dia. in. to ft., Dia. in. to ft.					
Casing height above land surface <u>36</u> in., weight <u>Sch. 40</u> lbs./ft. Wall thickness or gauge No. <u>154</u>					
TYPE OF SCREEN OR PERFORATION MATERIAL:					
1 Steel 3 Stainless steel 5 Fiberglass 8 RMP (SR) 10 Asbestos-cement					
2 Brass 4 Galvanized steel 6 Concrete tile 9 ABS 11 Other (specify)					
12 None used (open hole)					
SCREEN OR PERFORATION OPENINGS ARE:					
1 Continuous slot 3 Mill slot 5 Gauzed wrapped <u>8 Saw cut</u> 11 None (open hole)					
2 Louvered shutter 4 Key punched 6 Wire wrapped 9 Drilled holes					
7 Torch cut 10 Other (specify)					
SCREEN-PERFORATED INTERVALS: From <u>58</u> ft. to <u>48</u> ft., From ft. to ft.					
From ft. to ft., From ft. to ft.					
GRAVEL PACK INTERVALS: From <u>58</u> ft. to <u>46</u> ft., From ft. to ft.					
From ft. to ft., From ft. to ft.					
6 GROUT MATERIAL:					
1 Neat cement 2 Cement grout <u>3 Bentonite</u> 4 Other					
Grout Intervals: From <u>46</u> ft. to <u>3</u> ft., From ft. to ft., From ft. to ft.					
What is the nearest source of possible contamination:					
1 Septic tank 4 Lateral lines 7 Pit privy 10 Livestock pens 14 Abandoned water well					
2 Sewer lines 5 Cess pool 8 Sewage lagoon 11 Fuel storage 15 Oil well/Gas well					
3 Watertight sewer lines 6 Seepage pit 9 Feedyard 12 Fertilizer storage 16 Other (specify below)					
13 Insecticide storage					
Direction from well? How many feet?					
FROM	TO	LITHOLOGIC LOG	FROM	TO	PLUGGING INTERVALS
<u>0</u>	<u>30</u>	<u>Clayey & Sandy silt pale yellow</u>			
<u>30</u>	<u>38</u>	<u>silt & sand brown</u>			
<u>38</u>	<u>43</u>	<u>sand</u>			
<u>43</u>	<u>58</u>	<u>Silty sand & some clay</u>			
7 CONTRACTOR'S OR LANDOWNER'S CERTIFICATION: This water well was (<u>1</u> constructed, (2) reconstructed, or (3) plugged under my jurisdiction and was completed on (mo/day/year) <u>2-28-95</u> and this record is true to the best of my knowledge and belief. Kansas Water Well Contractor's License No. <u>425</u> This Water Well Record was completed on (mo/day/yr) <u>5-31-95</u> under the business name of <u>Burton Well Drilling</u> by (signature) <u>Jo Zeter</u>					