

WATER WELL PLUGGING RECORD

Form WWC-5P

KSA 82a-1212


ID NO.

OW1

1 LOCATION OF WATER WELL: County: Thomas Fraction 1/4 NE 1/4 SW 1/4 NE 1/4 Section Number 18 Township Number T 8 S Range Number 36 E X W

Street/Rural Address of Well Location; if unknown, distance & direction from nearest town or intersection: If at owner's address, check here X Global Positioning Systems (GPS) information: Latitude: NA Longitude: NA Elevation: NA

2 WATER WELL OWNER: Brewster Farmers Coop RR#, St. Address, Box #: 428 Kansas Ave. City, State ZIP Code: Brewster, KS 67732

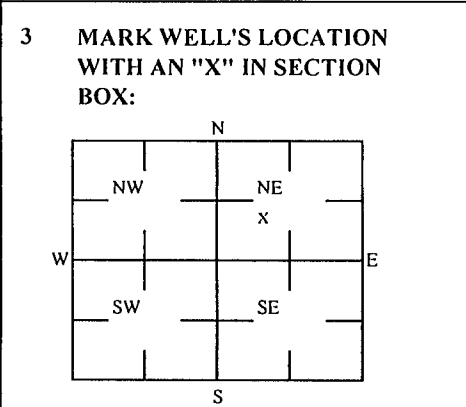

4 DEPTH OF WELL 127.6 ft. OW1 WELL'S STATIC WATER LEVEL NA ft WELL WAS USED AS: Domestic, Irrigation, Feedlot, Industrial, Public Water Supply, Oil Field Water Supply, Domestic (Lawn & Garden), Air Conditioning, Dewatering, Monitoring, Injection Well, Other

5 TYPE OF BLANK CASING USED: Steel, PVC, RMP (SR), ABS, Wrought, Asbestos-Cement, Fiberglass, Concrete Tile, Other (Specific below) Blank casing diameter 4 in. Was casing pulled? Yes X No

6 GROUT PLUG MATERIAL: Neat cement, Cement grout, Bentonite, Other Concrete: 0-1'; Soil: 1-3' Grout Plug Intervals: From 3 ft to 127.6 ft, From \_\_\_ ft to \_\_\_ ft, From \_\_\_ ft to \_\_\_ ft

Table with columns FROM, TO, PLUGGING MATERIALS. Rows: 0 to 1 Concrete, 1 to 3 Soil, 3 to 127.6 Bentonite. Includes KDHE ID: Frontier Equity Exchange; U6-097-00098

7 CONTRACTOR'S OR LANDOWNER'S CERTIFICATION: This water well was plugged under my jurisdiction and was completed on (mo/day/year) 1/8-12/19 and this record is true to the best of my knowledge and belief. Kansas Water Contractor's License No. 757. This Water Well Record was completed on (mo/day/year) 2/21/2019 under the business name of Larsen & Associates, Inc. By (signature)

Send one white copy to Kansas Department of Health & Environment, Geology Section, 1000 SW Jackson Street, Ste. 420, Topeka, KS 66612-1367. Send one copy to WATER WELL OWNER and retain one for your records Visit us at http://www.kdheks.gov/waterwell/index.html Telephone 785-296-5524.