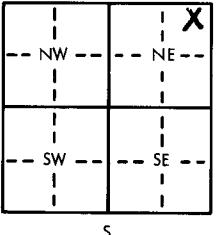



USE TYPEWRITER OR BALL POINT PEN-PRESS FIRMLY, PRINT CLEARLY.

MEWATER 11/11/77

WATER WELL RECORD
KSA 82a-1201-1215

Kansas Department of Health and Environment-Division of Environment (Water well Contractors) Topeka, Kansas 66620

1. Location of well: County SHERMAN Fraction NE 1/4 NE 1/4 NE 1/4 Section number 3 Township number T 8 S R 37 Range number 10	
2. Distance and direction from nearest town or city: Brewster Street address of well location if in city: 3W 2N 1/4 W	
3. Owner of well: VERNON PATTEN R.R. or street: R.R. 2 City, state, zip code: Brewster Kansas 67732	
4. Locate with "X" in section below: <div style="display: flex; align-items: center;"> <div style="border: 1px solid black; padding: 5px; margin-right: 20px;"> <p>1 Mile</p>  <p>1 Mile</p> </div> <div style="margin-right: 20px;"> <p>Cross PO on sketch map:</p> <p>X</p> </div> <div style="border: 1px solid black; padding: 5px; margin-right: 20px;"> <p>Shed</p> </div> <div style="border: 1px solid black; padding: 5px; margin-right: 20px;"> <p>House</p> </div> <div style="margin-right: 20px;"> <p>X</p> <p>well</p> </div> <div style="border: 1px solid black; padding: 5px;"> <p>Shed</p> </div> </div> <p>Grain Bins 00 00 00</p>	
5. Type and color of material	
6. Bore hole dia. <u>4</u> in. Completion date <u>8-15-77</u> Well depth <u>281</u> ft.	
7. Cable tool <input checked="" type="checkbox"/> Rotary <input type="checkbox"/> Driven <input type="checkbox"/> Dug <input type="checkbox"/> Hollow rod <input type="checkbox"/> Jetted <input type="checkbox"/> Bored <input type="checkbox"/> Reverse rotary	
8. Use: <input checked="" type="checkbox"/> Domestic <input type="checkbox"/> Public supply <input type="checkbox"/> Industry <input type="checkbox"/> Irrigation <input type="checkbox"/> Air conditioning <input type="checkbox"/> Stock <input type="checkbox"/> Lawn <input type="checkbox"/> Oil field water <input type="checkbox"/> Other	
9. Casing: Material <u>Plastic</u> Height: Above or below Threaded <input type="checkbox"/> Welded <input type="checkbox"/> Surface <u>12</u> in. RMP <input type="checkbox"/> PVC <input checked="" type="checkbox"/> Weight <u> </u> lbs./ft. Dia. <u>4</u> in. to <u>257</u> ft. depth Wall Thickness: inches or Dia. <u> </u> in. to <u> </u> ft. depth gage No. <u>237</u>	
10. Screen: Manufacturer's name <u>Jess + Howell</u> Type <u>lower</u> Dia. <u>5</u> Slot/gauze <u>1/8 258</u> Length <u>24</u> Set between <u>257</u> ft. and <u>281</u> ft. <u> </u> ft. and <u> </u> ft. Gravel pack? <u>yes</u> Size range of material <u>1/8</u>	
11. Static water level: <u>154.5</u> ft. below land surface Date <u>7-30-77</u> mo./day/yr.	
12. Pumping level below land surfaces: <u>170</u> ft. after <u>3</u> hrs. pumping <u>25</u> g.p.m. <u> </u> ft. after <u> </u> hrs. pumping <u> </u> g.p.m. Estimated maximum yield <u>50</u> g.p.m.	
13. Water sample submitted: <u> </u> mo./day/yr. Yes <input checked="" type="checkbox"/> No <input type="checkbox"/> Date <u> </u>	
14. Well head completion: <u>40</u> pitless adapter <u>12</u> inches above grade	
15. Well grouted? <u>yes</u> With: <input type="checkbox"/> Neat cement <input type="checkbox"/> Bentonite <input checked="" type="checkbox"/> Concrete Depth: From <u>5</u> ft. to <u>15</u> ft.	
16. Nearest source of possible contamination: <u>Cess pool</u> ft. <u>150</u> Direction <u>NW</u> Type <u>pool</u> Well disinfected upon completion? <input checked="" type="checkbox"/> Yes <input type="checkbox"/> No	
17. Pump: <input type="checkbox"/> Not installed Manufacturer's name <u>Dempster</u> Model number <u> </u> HP <u>1</u> Volts <u>230</u> Length of drop pipe <u>216</u> ft. capacity <u>15</u> g.p.m. Type: <input checked="" type="checkbox"/> Submersible <input type="checkbox"/> Turbine <input type="checkbox"/> Jet <input type="checkbox"/> Reciprocating <input type="checkbox"/> Centrifugal <input type="checkbox"/> Other	
18. Elevation: <u> </u>	
19. Remarks: <u>3473 (top)</u> REPLACEMENT WELL	
20. Water well contractor's certification: This well was drilled under my jurisdiction and this report is true to the best of my knowledge and belief. <u>A.H. Dunning Co Inc 166</u> Business name License No. Address <u>Howell, Kansas</u> Signed <u>Bill Clifford</u> Date <u>8-15-77</u> Authorized representative	

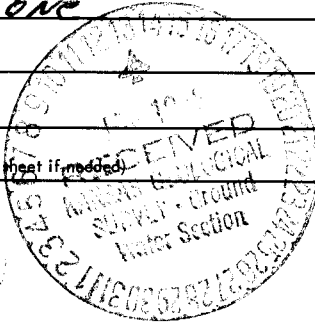

T 8 R 37 E 3 NE NE NE 1/4 1/4 1/4