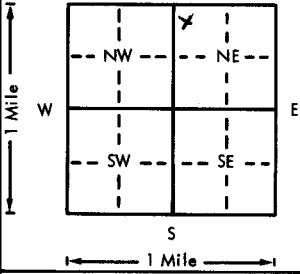


USE TYPEWRITER OR BALL
POINT PEN-PRESS FIRMLY,
PRINT CLEARLY.

WATER WELL RECORD
KSA 82a-1201-1215

Kansas Department of Health and
Environment-Division of Environment
(Water well Contractors)
Topeka, Kansas 66620

1. Location of well:		County SHERMAN	Fraction N 1/4 N 1/4 NE 1/4	Section number 4	Township number T 8 S R 37 E/W	Range number
2. Distance and direction from nearest town or city: Street address of well location if in city:		4 E - 3 N - Edson		3. Owner of well: Richard D. Bender R.R. or street: 703 Emerson City, state, zip code: Alma, Nebraska		
4. Locate with "X" in section below:		Sketch map:		6. Bore hole dia. 220 . Completion date 11-76 Well depth 280 ft.		
				7. Cable tool <input type="checkbox"/> Rotary <input type="checkbox"/> Driven <input type="checkbox"/> Dug <input type="checkbox"/> Hollow rod <input type="checkbox"/> Jetted <input type="checkbox"/> Bored <input checked="" type="checkbox"/> Reverse rotary		
5. Type and color of material		From		To		8. Use: Domestic <input type="checkbox"/> Public supply <input type="checkbox"/> Industry <input type="checkbox"/> <input checked="" type="checkbox"/> Irrigation <input type="checkbox"/> Air conditioning <input type="checkbox"/> Stock <input type="checkbox"/> Lawn <input type="checkbox"/> Oil field water <input type="checkbox"/> Other
Top soil		0		135		9. Casing: Material Steel Height: above or below Threaded <input type="checkbox"/> Welded <input checked="" type="checkbox"/> Surface 12 in. RMP <input type="checkbox"/> PVC <input type="checkbox"/> Weight <input type="checkbox"/> lbs./ft. Dia. 10 3/4 to 280 ft. depth Wall Thickness: inches or Dia. <input type="checkbox"/> in. to <input type="checkbox"/> ft. depth gage No. 177
Clay fine sand med gravel sandy clay		135		140		10. Screen: Manufacturer's name W H Brown Type louver Dia. 12 3/4 Slot/gauze <input type="checkbox"/> Length <input type="checkbox"/> Set between 220 ft. and 280 ft. ft. and <input type="checkbox"/> ft.
Med Gravel loose color		140		145		Gravel pack? <input checked="" type="checkbox"/> Size range of material 1/4 x 3/8
Fine sand M. Gravel loose color		145		180		11. Static water level: 164 ft. below land surface Date <input type="checkbox"/>
<input checked="" type="checkbox"/> loose color		180		185		12. Pumping level below land surfaces: 137 ft. after 3 hrs. pumping 1000 g.p.m. ft. after <input type="checkbox"/> hrs. pumping <input type="checkbox"/> g.p.m. Estimated maximum yield 1075 g.p.m.
<input checked="" type="checkbox"/> sandy clay		185		205		13. Water sample submitted: <input type="checkbox"/> Yes <input checked="" type="checkbox"/> No Date <input type="checkbox"/>
Fine sand M. Gravel sandy clay		205		210		14. Well head completion: Pitless adapter 12 inches above grade
Fine sand M. Gravel loose color S. clay		210		220		15. Well grouted? yes With: <input checked="" type="checkbox"/> Neat cement <input type="checkbox"/> Bentonite <input type="checkbox"/> Concrete Depth: From 0 ft. to 10 ft.
M. Gravel streak of sandy clay + sand stone		220		230		16. Nearest source of possible contamination: ft. <input type="checkbox"/> Direction <input type="checkbox"/> Type None Well disinfected upon completion? <input type="checkbox"/> Yes <input checked="" type="checkbox"/> No
Fine sand Med Gravel loose color sandy clay		230		260		17. Pump: Not installed Manufacturer's name Goulds Model number 8N16 HP <input type="checkbox"/> Volts <input type="checkbox"/> Length of drop pipe 270 ft. capacity 1000 g.p.m. Type: <input type="checkbox"/> Submersible <input checked="" type="checkbox"/> Turbine <input type="checkbox"/> Jet <input type="checkbox"/> Reciprocating <input type="checkbox"/> Centrifugal <input type="checkbox"/> Other
Fine sand M. Gravel loose gravel		260		275		20. Water well contractor's certification: This well was drilled under my jurisdiction and this report is true to the best of my knowledge and belief. Blair Jay Dickinson 218 Business name Blair Jay Dickinson License No. <input type="checkbox"/> Address 24503 Abby, Mo Signed Wmilyn Ball Date 4-77 Authorized representative
Med Gravel Reddish shale		275		280		
(Use a second sheet if needed)						
18. Elevation:		19. Remarks:				
Topography: <input type="checkbox"/> Hill <input type="checkbox"/> Slope <input checked="" type="checkbox"/> Upland <input type="checkbox"/> Valley						

8-37-4-
N 1/4 N 1/4 NE 1/4