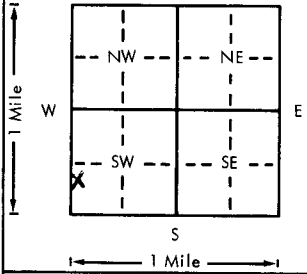
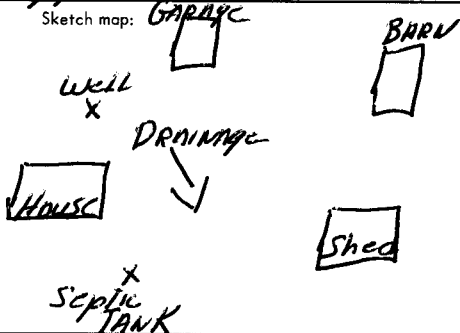


USE TYPEWRITER OR BALL  
POINT PEN-PRESS FIRMLY,  
PRINT CLEARLY.

WATER WELL RECORD  
KSA 82a-1201-1215

Kansas Department of Health and  
Environment-Division of Environment  
(Water well Contractors)  
Topeka, Kansas 66620

1. Location of well:		County <b>SHERMAN</b>	Fraction <b>NW 1/4 SW 1/4 SW 1/4</b>	Section number <b>16</b>	Township number <b>T 8 S</b>	Range number <b>R 37 W</b>
2. Distance and direction from nearest town or city: <b>Brewster</b> Street address of well location if in city: <b>5 W 3/4 S</b>			3. Owner of well: <b>WILLIAM Selby</b> R.R. or street: <b>RR 1</b> City, state, zip code: <b>Brewster Kansas 67732</b>			
4. Locate with "X" in section below: 			Sketch map: 		6. Bore hole dia. <b>8</b> in. Completion date <b>4-13-78</b> Well depth <b>230</b> ft.	
5. Type and color of material			From	To	7. <input checked="" type="checkbox"/> Cable tool <input checked="" type="checkbox"/> Rotary <input type="checkbox"/> Driven <input type="checkbox"/> Dug <input type="checkbox"/> Hollow rod <input type="checkbox"/> Jetted <input type="checkbox"/> Bored <input type="checkbox"/> Reverse rotary	
Top Soil			0	4	8. Use: <input checked="" type="checkbox"/> Domestic <input type="checkbox"/> Public supply <input type="checkbox"/> Industry <input type="checkbox"/> Irrigation <input type="checkbox"/> Air conditioning <input type="checkbox"/> Stock <input type="checkbox"/> Lawn <input type="checkbox"/> Oil field water <input type="checkbox"/> Other	
Clay			4	40	9. Casing: Material <b>Plastic</b> Height: Above or below Threaded <input type="checkbox"/> Welded <input type="checkbox"/> Surface <b>12</b> in. RMP <input type="checkbox"/> PVC <input checked="" type="checkbox"/> Weight <input type="checkbox"/> lbs./ft.	
M Gravel			40	46	Dia. <b>4</b> in. to <b>2 1/4</b> ft. depth Wall Thickness: inches or Dia. <input type="checkbox"/> in. to <input type="checkbox"/> ft. depth gage No. <b>237</b>	
Clay, Sandstone			46	113	10. Screen: Manufacturer's name <b>Peerless</b> Type <b>14yrer</b> Dia. <b>5</b> Slot/gauze <b>18 258</b> Length <b>16</b> Set between <b>217</b> ft. and <b>230</b> ft. Gravel pack? <b>yes</b> Size range of material <b>18</b>	
M Gravel			113	140	11. Static water level: <input type="checkbox"/> mo./day/yr. <b>121</b> ft. below land surface Date <b>4-1-78</b>	
Sandy Clay, Sandstone			140	154	12. Pumping level below land surfaces: <b>145</b> ft. after <b>3</b> hrs. pumping <b>20</b> g.p.m. ft. after <input type="checkbox"/> hrs. pumping <input type="checkbox"/> g.p.m. Estimated maximum yield <b>50</b> g.p.m.	
M Gravel			154	163	13. Water sample submitted: <input type="checkbox"/> mo./day/yr. <input type="checkbox"/> Yes <input checked="" type="checkbox"/> No Date <input type="checkbox"/>	
Sandy Clay			163	176	14. Well head completion: <input checked="" type="checkbox"/> Pitless adapter <b>12</b> Inches above grade	
M Gravel			176	181	15. Well grouted? <b>yes</b> With: <input checked="" type="checkbox"/> Neat cement <input type="checkbox"/> Bentonite <input type="checkbox"/> Concrete Depth: From <b>5</b> ft. to <b>15</b> ft.	
Clay, Rock			181	194	16. Nearest source of possible contamination: <b>Sherman</b> ft. <b>210</b> Direction <b>SW</b> Type <b>river</b> Well disinfected upon completion? <input checked="" type="checkbox"/> Yes <input type="checkbox"/> No	
M Gravel, Sandstone			194	215	17. Pump: Manufacturer's name <b>Reda</b> Not installed Model number <b>1209P211</b> HP <b>3/4</b> Volts <b>230</b> Length of drop pipe <b>168</b> ft. capacity <b>15</b> g.p.m. Type: <input checked="" type="checkbox"/> Submersible <input type="checkbox"/> Turbine <input type="checkbox"/> Jet <input type="checkbox"/> Reciprocating <input type="checkbox"/> Centrifugal <input type="checkbox"/> Other	
M Gravel			215	226	20. Water well contractor's certification: This well was drilled under my jurisdiction and this report is true to the best of my knowledge and belief. <b>Stitt Drilling Co. Inc 166</b> Business name <b>Broadway Kansas</b> License No. Address <b>Broadway Kansas</b> Signed <b>B. Stitt</b> Date <b>4-13-78</b> Authorized representative	
Cchrc			226	230		
(Use a second sheet if needed)						
18. Elevation:		19. Remarks: <b>3462 (TOPO)</b>		20. Water well contractor's certification: This well was drilled under my jurisdiction and this report is true to the best of my knowledge and belief. <b>Stitt Drilling Co. Inc 166</b> Business name <b>Broadway Kansas</b> License No. Address <b>Broadway Kansas</b> Signed <b>B. Stitt</b> Date <b>4-13-78</b> Authorized representative		
Topography: <input type="checkbox"/> Hill <input type="checkbox"/> Slope <input checked="" type="checkbox"/> Upland <input type="checkbox"/> Valley						

8  
3  
7  
16  
NW SW SW  
1/4 1/4 1/4