

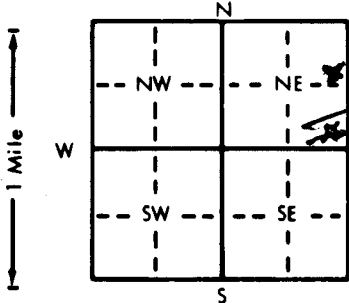
1 LOCATION OF WATER WELL: County: <u>SHERMAN</u>	Fraction <u>SE 1/4 NE 1/4 NE 1/4</u>	Section Number <u>16</u>	Township Number T <u>8</u> S	Range Number R <u>37</u> E <u>W</u>
---	---	-----------------------------	---------------------------------	--

Distance and direction from nearest town or city street address of well if located within city?

4 mi. WEST BREWSTER

2 WATER WELL OWNER: RR#, St. Address, Box # : City, State, ZIP Code	<u>EVERETT CRAFT</u> <u>803 WASHINGTON</u> <u>GOODLAND KS. 67735</u>	Board of Agriculture, Division of Water Resources Application Number:
---	--	--

3 LOCATE WELL'S LOCATION WITH AN "X" IN SECTION BOX:	4 DEPTH OF COMPLETED WELL <u>200</u> ft. ELEVATION:
--	---


WELL WATER TO BE USED AS:

1 Domestic	3 Feedlot	6 Oil field water supply	9 Dewatering	12 Other (Specify below)
2 Irrigation	4 Industrial	7 Lawn and garden only	10-Monitoring well	

Was a chemical/bacteriological sample submitted to Department? Yes No; If yes, mo/day/yr sample was sub-

mitted

Water Well Disinfected? Yes No

5 TYPE OF BLANK CASING USED:	5 Wrought iron	8 Concrete tile	CASING JOINTS <u>Grouted</u>	Clamped
1 Steel	3 RMP (SR)	6 Asbestos-Cement	9 Other (specify below)	Welded
<u>2 PVC</u>	4 ABS	7 Fiberglass		Threaded


TYPE OF SCREEN OR PERFORATION MATERIAL:

1 Steel	3 Stainless steel	5 Fiberglass	8 RMP (SR)	11 Other (specify)
2 Brass	4 Galvanized steel	6 Concrete tile	9 ABS	12 None used (open hole)

SCREEN OR PERFORATION OPENINGS ARE:

1 Continuous slot	3 Mill slot	5 Gauzed wrapped	<u>8 Saw cut</u>	11 None (open hole)
2 Louvered shutter	4 Key punched	6 Wire wrapped	9 Drilled holes	
		7 Torch cut	10 Other (specify)	


6 GROUT MATERIAL:	<u>1 Neat cement</u>	2 Cement grout	3 Bentonite	4 Other
-------------------	----------------------	----------------	-------------	---------


What is the nearest source of possible contamination:

<u>1 Septic tank</u>	4 Lateral lines	7 Pit privy	10 Livestock pens	14 Abandoned water well
2 Sewer lines	5 Cess pool	8 Sewage lagoon	11 Fuel storage	15 Oil well/Gas well
3 Watertight sewer lines	6 Seepage pit	9 Feedyard	12 Fertilizer storage	16 Other (specify below)
			13 Insecticide storage	

Direction from well? NORTHHow many feet? 2000

FROM TO LITHOLOGIC LOG FROM TO PLUGGING INTERVALS

FROM TO LITHOLOGIC LOG FROM TO PLUGGING INTERVALS

7 CONTRACTOR'S OR LANDOWNER'S CERTIFICATION: This water well was (1) constructed, (2) reconstructed, or (3) plugged under my jurisdiction and wascompleted on (mo/day/year) 10-1-90 and this record is true to the best of my knowledge and belief. KansasWater Well Contractor's License No. HB4 This Water Well Record was completed on (mo/day/yr) 10-1-90under the business name of SCHAAL DRILLING by (signature) Ruben Schaal