

USE TYPEWRITER OR BALL POINT PEN-PRESS FIRMLY, PRINT CLEARLY.

EDSON

T R EW sec 1/4 1/4 1/4 No.


WATER WELL RECORD
KSA 82a-1201-1215

Kansas State Dept. Of Health
(Water Well Contractors)
Forbes-Bldg. 740
Topeka, Kansas 66620

BBB

1 Location of well: County SHERMAN Township name LANES NW 1/4 NW 1/4 Fraction 18 Section number 18 Town number 8 S Range number 37 W

Distance and direction from nearest town or city: Edson 2 E 2 N
Street address of well location if in city:
3 Owner of well: John Holste
Address: Edson Kansas

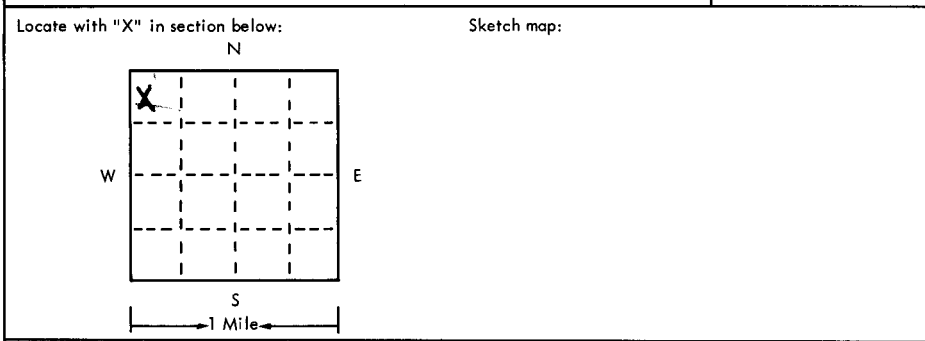

4 Well depth: 225 ft. Date of completion 3-20-75
Well diameter 8 in.
5 Cable tool Rotary Driven Dug
 Hollow rod Jetted Bored Reverse rotary
6 Use: Domestic Public supply Industry
 Irrigation Air conditioning Commercial
 Test well
7 Casing: Material Plastic Height: above/below
Threaded Welded Surface 12 in.
Diam. 4 in. to 209 ft. depth Drive shoe? Yes No
4 in. to ft. depth

2	Type and color of material	From	To
	<u>GRAVEL, SANDY CLAY, SANDSTONE</u>	<u>95</u>	<u>121</u>
	<u>M GRAVEL</u>	<u>121</u>	<u>127</u>
	<u>GRAVEL, SANDY CLAY SANDSTONE</u>	<u>127</u>	<u>148</u>
	<u>M GRAVEL</u>	<u>148</u>	<u>151</u>
	<u>M GRAVEL, SANDY CLAY, SANDSTONE</u>	<u>151</u>	<u>157</u>
	<u>SANDY CLAY, SANDSTONE</u>	<u>157</u>	<u>161</u>
	<u>M GRAVEL, SANDY CLAY, SANDSTONE</u>	<u>161</u>	<u>168</u>
	<u>SANDY CLAY, SANDSTONE</u>	<u>168</u>	<u>172</u>
	<u>M GRAVEL, SANDY CLAY, SANDSTONE</u>	<u>172</u>	<u>184</u>
	<u>SANDY CLAY, SANDSTONE</u>	<u>184</u>	<u>186</u>
	<u>HARD SANDSTONE</u>	<u>186</u>	<u>189</u>
	<u>GRAVEL, SANDSTONE</u>	<u>189</u>	<u>196</u>
	<u>GRAVEL</u>	<u>196</u>	<u>201</u>
	<u>FINE SAND, GRAVEL, SANDSTONE</u>	<u>201</u>	<u>223</u>
	<u>OCHRE</u>	<u>223</u>	<u>225</u>

8 Screen: Manufacturer Jess + Lowell
Type Luxen Dia. 5
Slot/gauze 1/8, 200 Length 16
Set between 209 ft. and 222 ft.
Fittings: Gravel pack Yes No Size range of material 1/8
9 Static water level: 93 ft. below land surface Date 3-22-75
10 Pumping level below land surfaces: 130 ft. after 3 hrs. pumping 50 g.p.m.
 ft. after hrs. pumping g.p.m.
Estimated maximum yield 50 g.p.m.
11 Water sample submitted: Yes No Date
12 Well head completion: Pitless adapter 12 Inches above grade
13 Well grouted? Yes No
 Neat cement Bentonite
Depth: From 5 ft. to 15 ft.
14 Nearest source of possible contamination: Cess Poles
ft. 220 Direction NORTH Type
Well disinfected upon completion? Yes No
15 Pump: Not installed
Manufacturer's name Red Jacket
Model number 19BC HP 1 1/2 Volts 220
Length of drop pipe 210 ft. capacity 20 g.p.m.
Type: Submersible Turbine
 Jet Reciprocating
 Centrifugal Other

16 Remarks: elevation 3465 (TOPO)
Topography: Hill Slope Upland Valley
(use a second sheet if needed)

17 Water well contractor's certification:
This well was drilled under my jurisdiction and this report is true to the best of my knowledge and belief.
S & H Drilling Co Inc 1166
Business name Woodland License No.
Address
Signed Red Jacket Date 4-22-75
Authorized representative