

BREWSTER

USE TYPEWRITER OR BALL POINT PEN—PRESS FIRMLY, PRINT CLEARLY.

--	--	--	--	--	--	--	--	--	--	--

T R EW sec 1/4 1/4 1/4 No.

BAA
NE 1/4 NE 1/4 NW 1/4

WATER WELL RECORD
KSA 82a-1201-1215

Kansas State Dept. Of Health
(Water Well Contractors)
Forbes-Bldg. 740
Topeka, Kansas 66620


1 Location of well:	County <u>SHERMAN</u>	Township name <u>UNION</u>	Fraction <u>NE 1/4</u>	Section number <u>22</u>	Town number <u>T85</u>	Range number <u>R37W</u>
---------------------	--------------------------	-------------------------------	---------------------------	-----------------------------	---------------------------	-----------------------------

Distance and direction from nearest town or city: Edson

Street address of well location if in city: 6 E

3 Owner of well: John Brooks

Address: Goodland Kansas

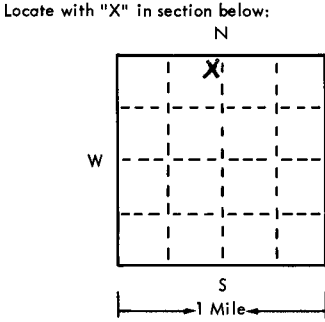

Sketch map:

4 Well depth: 218 ft. Date of completion: 2-1-75
Well diameter 26 in.

5 Cable tool Rotary Driven Dug
 Hollow rod Jetted Bored Reverse rotary

6 Use: Domestic Public supply Industry
 Irrigation Air conditioning Commercial
 Test well

7 Casing: Material Steel Height: above/below
Threaded Welded Surface 29 in.
Dia. 16 in. Weight 33 lbs./ft. 1
16 in. to 218 ft. depth Drive shoe? Yes No
 in. to ft. depth

2	Type and color of material	From	To
	<u>SANDY CLAY SANDSTONE</u>	<u>88</u>	<u>117</u>
	<u>M GRAUGH, SANDY CLAY, SANDSTONE</u>	<u>117</u>	<u>156</u>
	<u>M GRAUGH, SANDSTONE</u>	<u>156</u>	<u>175</u>
	<u>M GRAUGH, SANDY CLAY, SANDSTONE</u>	<u>175</u>	<u>194</u>
	<u>M, GRAUGH, SANDSTONE</u>	<u>194</u>	<u>205</u>
	<u>FINE SAND, M GRAUGH, SANDSTONE</u>	<u>205</u>	<u>214</u>
	<u>Obree</u>	<u>214</u>	<u>218</u>
	<u>BROOK 34</u>		

8 Screen: Manufacturer W A BROWN
Type LUGER Dia. 16
Slot/gauze 1/8 Length 90
Set between 124 ft. and 214 ft.
Fittings:
Gravel pack Yes No Size range of material 4/20

9 Static water level:
118 ft. below land surface Date 1-1-75

10 Pumping level below land surfaces:
200 ft. after 4 hrs. pumping 300 g.p.m.
 ft. after ___ hrs. pumping ___ g.p.m.
Estimated maximum yield 300 g.p.m.

11 Water sample submitted:
 Yes No Date ___

12 Well head completion: 12
 Pitless adapter Inches above grade

13 Well grouted? Yes No
 Neat cement Bentonite ___
Depth: From 0 ft. to 10 ft.

14 Nearest source of possible contamination:
ft. ___ Direction ___ Type None
Well disinfected upon completion? Yes No

15 Pump: Not installed
Manufacturer's name Western Land Ruler
Model number 6M HP 30 Volts ___
Length of drop pipe 210 ft. capacity 300 g.m.p.
Type:
 Submersible Turbine
 Jet Reciprocating
 Centrifugal Other

16 Remarks: elevation 3465 (TOTO)

Topography:
 Hill
 Slope
 Upland
 Valley

17 Water well contractor's certification:
This well was drilled under my jurisdiction and this report is true to the best of my knowledge and belief.
SH Drilling Co Inc License No. 166
Business name
Address Goodland Kansas
Signed Bill Piffard Date 2-11-75
Authorized Representative

Forward the white, blue and pink copies to the Kansas State Dept. Of Health.

Form WWC-5