USE TYPEWRITER OR BALL POINT PEN-PRESS FIRMLY, PRINT CLEARLY.

T R EW sec 1/4 1/4 1/4 No.

WATER WELL RECORD
KSA 82a-1201-1215

~~BAB~~ ABB

Kansas State Dept. Of Health
(Water Well Contractors)
Forbes-Bldg. 740
Topeka, Kansas 66620

1 Location of well:	County	Township name	Fraction	Section number	Town number	Range number
	Sherman	Union	NE¼ NW¼	26	8	37

Distance and direction from nearest town or city: Edson

Street address of well location if city: 6¼ E

3 Owner of well: John Brooks

Address: Goodland, Kansas

Locate with "X" in section below:

Sketch map:

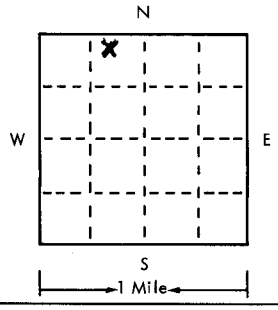

4 Well depth: 233 ft. Date of completion 5-14-75
Well diameter 26 in.

5 ☐ Cable tool ☐ Rotary ☐ Driven ☐ Dug
☐ Hollow rod ☐ Jetted ☐ Bored ☒ Reverse rotary

6 Use: ☐ Domestic ☐ Public supply ☐ Industry
☒ Irrigation ☐ Air conditioning ☐ Commercial
☐ Test well ☐

7 Casing: Material Steel Height: above/~~below~~
Threaded ☐ Welded ☒ Surface 12 in.
Diam. Weight 33 lbs./ft. 1
16 in. to 133 ft. depth Drive shoe? ☐ Yes ☒ No
___ in. to ___ ft. depth

2 Type and color of material	From	To
Fine Sand, Clay, Sandstone	98	111
M Gravel	111	116
M Gravel, Sandstone	116	128
Fine Sand, Gravel, Clay	128	151
Gravel	151	156
M Gravel, Sandy Clay	156	160
Fine Sand, Sandstone	160	188
Sandy Clay	188	191
M Gravel	191	213
Trace Gravel, Sandy Clay	213	231
Ochre	231	233
(use a second sheet if needed)		

8 Screen:
Manufacturer W.A. Brown
Type Liner Dia. 16
Slot/gauze 18-7 Length 110
Set between 133 ft. and 133 ft.
Fittings:
Gravel pack ☒ Yes ☐ No Size range of material 1/4 to 5/8

9 Static water level:
99 ft. below land surface Date 5-16-75

10 Pumping level below land surfaces:
210 ft. after 5 hrs. pumping 900 g.p.m.
___ ft. after ___ hrs. pumping ___ g.p.m.
Estimated maximum yield 900 g.p.m.

11 Water sample submitted:
☐ Yes ☒ No Date ___

12 Well head completion:
☐ Pitless adapter ☐ Inches above grade

13 Well grouted? ☒ Yes ☐ No
☒ Neat cement ☐ Bentonite ☐ ___
Depth: From 0 ft. to 10 ft.

14 Nearest source of possible contamination:
ft. ___ Direction ___ Type None
Well disinfected upon completion? ☐ Yes ☐ No

15 Pump: ☐ Not installed
Manufacturer's name Western Land Roller
Model number 8M HP 75 Volts 440
Length of drop pipe 210 ft. capacity 900 g.m.p.
Type:
☐ Submersible ☒ Turbine
☐ Jet ☐ Reciprocating
☐ Certrifugal ☐ Other

16 Remarks: elevation 3440 (TOTO)

Topography:
☐ Hill
☐ Slope
☒ Upland
☐ Valley

17 Water well contractor's certification:
This well was drilled under my jurisdiction and this report is true to the best of my knowledge and belief.
L H Drilling Co Inc 166
Business name License No.
Address Goodland, Kan
Signed Bill Clifford Date 6-3-75
Authorized representative

Forward the white, blue and pink copies to the Kansas State Dept. Of Health.

Form WWC-5