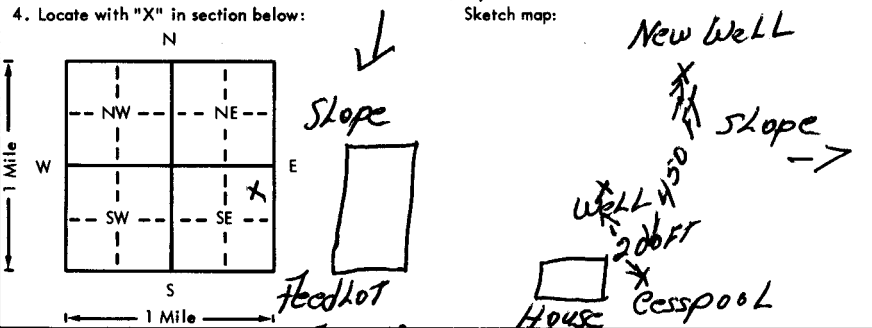


USE TYPEWRITER OR BALL
POINT PEN-PRESS FIRMLY,
PRINT CLEARLY.

WATER WELL RECORD
KSA 82a-1201-1215

Kansas Department of Health and
Environment-Division of Environment
(Water well Contractors)
Topeka, Kansas 66620

DAA

1. Location of well:		County <u>SHERMAN</u>	Fraction <u>NE 1/4 NE 1/4 SE 1/4</u>	Section number <u>26</u>	Township number T <u>8</u> S	Range number R <u>37</u> E/W
2. Distance and direction from nearest town or city: <u>Edson</u> Street address of well location if in city: <u>7 E 3/4 S</u>				3. Owner of well: <u>JOHN BROOKS</u> R.R. or street: <u>513 WALNUT</u> City, state, zip code: <u>Goodland Kansas</u>		
4. Locate with "X" in section below: 				6. Bore hole dia. <u>8"</u> in. Completion date <u>4-12-76</u> Well depth <u>155</u> ft.		
5. Type and color of material				7. <input type="checkbox"/> Cable tool <input checked="" type="checkbox"/> Rotary <input type="checkbox"/> Driven <input type="checkbox"/> Dug <input type="checkbox"/> Hollow rod <input type="checkbox"/> Jetted <input type="checkbox"/> Bored <input type="checkbox"/> Reverse rotary		
				8. Use: <input checked="" type="checkbox"/> Domestic <input type="checkbox"/> Public supply <input type="checkbox"/> Industry <input type="checkbox"/> Irrigation <input type="checkbox"/> Air conditioning <input type="checkbox"/> Stock <input type="checkbox"/> Lawn <input type="checkbox"/> Oil field water <input type="checkbox"/> Other		
M. GRAVEL SANDY CLAY, ROCK CLAY, SANDSTONE SANDY CLAY SANDSTONE M GRAVEL SANDY CLAY, SANDSTONE M GRAVEL, SANDSTONE M GRAVEL, SANDY CLAY, SANDSTONE FINE SAND, CLAY M GRAVEL SANDY CLAY OCHRE BROCK 152'				9. Casing: Material <u>Plastic</u> Height: Above or below Threaded <input type="checkbox"/> Welded <input type="checkbox"/> Surface <u>12</u> in. RMP <input type="checkbox"/> PVC <input checked="" type="checkbox"/> Weight <u>18</u> lbs./ft. Dia. <u>15"</u> in. to <u>131</u> ft. depth Wall Thickness: inches or Dia. <u>15"</u> in. to <u>131</u> ft. depth Gage No. <u>200-258</u>		
				10. Screen: Manufacturer's name <u>JESSY LOWELL</u> Type <u>LUVER</u> Dia. <u>5</u> Slot/gauze <u>1/8" 200</u> Length <u>24</u> Set between <u>131</u> ft. and <u>155</u> ft. Gravel pack? <u>Yes</u> Size range of material <u>1/8</u>		
				11. Static water level: <u>69</u> ft. below land surface Date <u>3-23-76</u>		
				12. Pumping level below land surfaces: <u>115</u> ft. after <u>2</u> hrs. pumping <u>45</u> g.p.m. ____ ft. after ____ hrs. pumping ____ g.p.m. Estimated maximum yield <u>50</u> g.p.m.		
				13. Water sample submitted: ____ mo./day/yr. <input type="checkbox"/> Yes <input checked="" type="checkbox"/> No Date ____		
				14. Well head completion: <input type="checkbox"/> Pitless adapter <u>12</u> inches above grade		
				15. Well grouted? <u>Yes</u> With: <input checked="" type="checkbox"/> Neat cement <input type="checkbox"/> Bentonite <input checked="" type="checkbox"/> Concrete Depth: From <u>5</u> ft. to <u>15</u> ft.		
				16. Nearest source of possible contamination: ft. <u>450</u> Direction <u>SW</u> Type <u>Cesspool</u> Well disinfected upon completion? <input checked="" type="checkbox"/> Yes <input type="checkbox"/> No		
				17. Pump: Not installed Manufacturer's name <u>Red Jacket</u> Model number <u>30014-110C</u> HP <u>3</u> Volts <u>220</u> Length of drop pipe <u>145</u> ft. capacity <u>30</u> g.p.m. Type: <input checked="" type="checkbox"/> Submersible <input type="checkbox"/> Turbine <input type="checkbox"/> Jet <input type="checkbox"/> Reciprocating <input type="checkbox"/> Centrifugal <input type="checkbox"/> Other		
				20. Water well contractor's certification: This well was drilled under my jurisdiction and this report is true to the best of my knowledge and belief. <u>S & H Drilling Co Inc 166</u> Business name <u>Goodland Kansas</u> License No. ____ Address <u>Bill Clifford</u> Signed <u>Bill Clifford</u> Date <u>4-14-76</u> Authorized representative		
18. Elevation:		19. Remarks:				
Topography: <input type="checkbox"/> Hill <input type="checkbox"/> Slope <input checked="" type="checkbox"/> Upland <input type="checkbox"/> Valley						