


| | | |
|---|---|---|
| 2 | WATER WELL OWNER: Bill Sandy | |
| | RR#, St. Address, Box # : 2125 Road 64 | Board of Agriculture, Division of Water Resources |
| | City, State, ZIP Code : Goodland, Ks. 67735 | Application Number: |

4 DEPTH OF COMPLETED WELL..... 256 ft. ELEVATION:

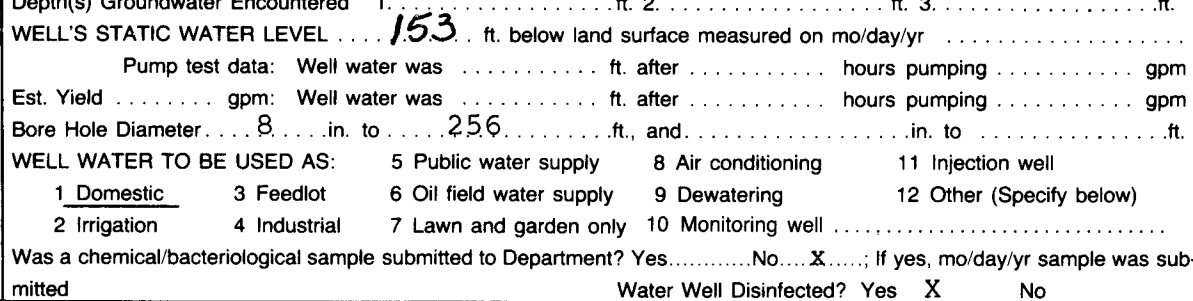

| | | | | |
|---|--------------------|-----------------|------------|--------------------------|
| TYPE OF SCREEN OR PERFORATION MATERIAL: | | | 7 PVC | 10 Asbestos-cement |
| 1 Steel | 3 Stainless steel | 5 Fiberglass | 8 RMP (SR) | 11 Other (specify) |
| 2 Brass | 4 Galvanized steel | 6 Concrete tile | 9 ABS | 12 None used (open hole) |

6 GROUT MATERIAL: 1 Neat cement 2 Cement grout 3 Bentonite 4 Other
Grout Intervals: From 0 ft. to 20 ft., From . ft. to . ft., From . ft. to . ft.
What is the nearest source of possible contamination: NONE 10 Livestock pens 14 Abandoned water well

| FROM | TO | LITHOLOGIC LOG | FROM | TO | PLUGGING INTERVALS |
|------|----|----------------|------|-----|----------------------|
| 0 | 2 | Gravel | 122 | 123 | Mod. Gravel/Gl. Silt |

| | | | | | |
|------|------|-------------------------------|-------|-------|-------------------------------|
| 0 | 2 | Surface | 123 | 126 | Med. Sand w/Clay Strks. |
| 2 | 20 | Loess | 126 | 131 | Sandy Clay |
| 20 | 35 | Clay & Caliche | 131 | 133 | Med. Sand |
| 35 | 37 | Clay & Caliche w/Med. Sand | 133 | 135 | Caliche |
| 37 | 40 | Med. Sand w/Clay Cem. Strks. | 135 | 142 | Sandy Clay w/Caliche Strks. |
| 40 | 49 | Cemented Sand w/Clay | 142 | 155 | Fine to Med. Sand w/Clay Str |
| 49 | 57 | Sandy Clay w/Caliche | 155 | 172 | Fine to Med. Sand w/Cem. Str |
| 57 | 80 | Med. Sand & Gravel w/Clay Ly | 172 | 176 | Med. Sand & Gravel |
| 80 | 85 | Sandy Clay , Caliche Cem.Sand | 176 | 183 | Cemented Sand w/Clay & S.Sand |
| 85 | 90 | Med. Sand & Gravel | 183 | 190 | Sandy Clay,Cem.Sand,&S.Sand |
| 90 | 90.5 | Caliche | 190 | 206 | Fine to Med. Sand w/Clay Lyr |
| 90.5 | 98 | Sandy Clay w/Caliche Strks. | 206 | 206.5 | Cemented Sand |
| 98 | 105 | Med. Sand | 206.5 | 212.5 | Med. Sand & Gravel |
| 105 | 110 | Sandy Clay w/Cem. Sand Strks. | 212.5 | 218 | Sandy Clay Caliche Cem.Sand |
| 110 | 123 | Sandy Clay w/Cem St&Med. Sand | 218 | 253 | Sand & Gravel 253-8 Ochre |

INSTRUCTIONS: Use typewriter or ball point pen. PLEASE PRESS FIRMLY and PRINT clearly. Please fill in blanks, underline or circle the correct answers. Send top three copies to Kansas Department of Health and Environment, Bureau of Water, Topeka, Kansas 66620-0001. Telephone: 913-296-5545. Send one to WATER WELL OWNER and retain one for your records.