


1 LOCATION OF WATER WELL: Fraction Section Number Township Number Range Number  
 County: **SHERMAN** SE 1/4 SE 1/4 SE 1/4 15 T 8S S R 38W E/W

Distance and direction from nearest town or city street address of well if located within city?

*1 1/2 North Edson KS*

2 WATER WELL OWNER: Dale Mitchek  
 RR#, St. Address, Box #: 1105 E. 10th  
 City, State, ZIP Code: Goodland, KS 67735  
 Board of Agriculture, Division of Water Resources  
 Application Number:

3 LOCATE WELL'S LOCATION WITH AN "X" IN SECTION BOX:

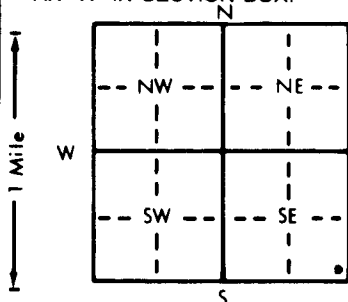

4 DEPTH OF COMPLETED WELL: 220' ft. ELEVATION:

Depth(s) Groundwater Encountered 1. 95' ft. 2. ft. 3. ft.

WELL'S STATIC WATER LEVEL 95' ft. below land surface measured on mo/day/yr

Pump test data: Well water was ft. after hours pumping gpm

Est. Yield 1.0 gpm: Well water was ft. after hours pumping gpm

Bore Hole Diameter 8 in. to ft. and in. to ft.

WELL WATER TO BE USED AS: 5 Public water supply 8 Air conditioning 11 Injection well

1 Domestic 3 Feedlot 6 Oil field water supply 9 Dewatering 12 Other (Specify below)

2 Irrigation 4 Industrial 7 Lawn and garden only 10 Monitoring well

Was a chemical/bacteriological sample submitted to Department? Yes No XX If yes, mo/day/yr sample was submitted  
 Water Well Disinfected? Yes No

5 TYPE OF BLANK CASING USED: 5 Wrought iron 8 Concrete tile CASING JOINTS: Glued Clamped

1 Steel 3 RMP (SR) 6 Asbestos-Cement 9 Other (specify below) Welded

2 PVC 4 ABS 7 Fiberglass Threaded

Blank casing diameter 4.5 in. to 200' ft. Dia. in. to ft. Dia. in. to ft.

Casing height above land surface 12 in. weight 160 lbs./ft. Wall thickness or gauge No. SDR26

TYPE OF SCREEN OR PERFORATION MATERIAL: 7 PVC 10 Asbestos-cement

1 Steel 3 Stainless steel 5 Fiberglass 8 RMP (SR) 11 Other (specify)

2 Brass 4 Galvanized steel 6 Concrete tile 9 ABS 12 None used (open hole)

SCREEN OR PERFORATION OPENINGS ARE: 5 Gauzed wrapped 8 Saw cut 11 None (open hole)

1 Continuous slot 3 Mill slot 6 Wire wrapped 9 Drilled holes

2 Louvered shutter 4 Key punched 7 Torch cut 10 Other (specify)

SCREEN-PERFORATED INTERVALS: From 200' ft. to 220' ft. From ft. to ft.

From ft. to ft. From ft. to ft.

GRAVEL PACK INTERVALS: From 95' ft. to 220' ft. From ft. to ft.

8-12 silica sand returns From 20' ft. to 95' ft. From ft. to ft.

6 GROUT MATERIAL: 1 Neat cement 2 Cement grout 3 Bentonite 4 Other

Grout Intervals: From 0 ft. to 20 ft. From ft. to ft. From ft. to ft.

What is the nearest source of possible contamination: 10 Livestock pens 14 Abandoned water well

1 Septic tank 4 Lateral lines 7 Pit privy 11 Fuel storage 15 Oil well/Gas well

2 Sewer lines 5 Cess pool 8 Sewage lagoon 12 Fertilizer storage 16 Other (specify below)

3 Watertight sewer lines 6 Seepage pit 9 Feedyard 13 Insecticide storage

Direction from well? NONE IN VIEW How many feet?

FROM TO LITHOLOGIC LOG FROM TO PLUGGING INTERVALS

0 40 clay

40 180 sandstone layered clay

180 220 med. sand

220 shale

7 CONTRACTOR'S OR LANDOWNER'S CERTIFICATION: This water well was (1) constructed, (2) reconstructed, or (3) plugged under my jurisdiction and was completed on (mo/day/year) 4-18-94 and this record is true to the best of my knowledge and belief. Kansas

Water Well Contractor's License No. 484 This Water Well Record was completed on (mo/day/yr) 4-18-94

under the business name of Schaal Drilling, Co. by (signature) Ruben Schaal