

USE TYPEWRITER OR BALL POINT PEN-PRESS FIRMLY, PRINT CLEARLY.

T R EW sec 1/4 1/4 1/4 No.


WATER WELL RECORD  
KSA 82a-1201-1215

Kansas State Dept. Of Health  
(Water Well Contractors)  
Forbes-Bldg. 740  
Topeka, Kansas 66620

470  
150  
ACA

1 Location of well: County Sherman Township name Washington Fraction NE 1/4 Section number 22 Town number 8 Range number 38

Distance and direction from nearest town or city: 1/2 mile north Edson Kansas  
Street address of well location if in city: \_\_\_\_\_  
3 Owner of well: Walker Briney  
Address: Edson Kans

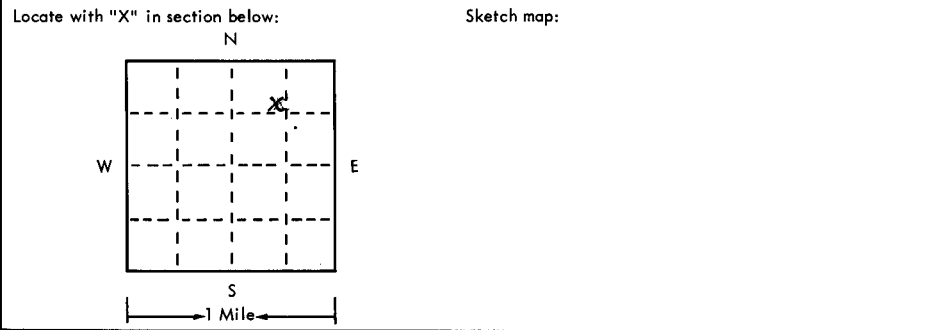

4 Well depth: 282 ft. Date of completion 7-7-75  
Well diameter 16 in.  
5  Cable tool  Rotary  Driven  Dug  
 Hollow rod  Jetted  Bored  Reverse rotary  
6 Use:  Domestic  Public supply  Industry  
 Irrigation  Air conditioning  Commercial  
 Test well  
7 Casing: Material Steel Height: above/below  
Threaded  Welded  Surface 8 in.  
Diag. 16 in. to 282 ft. depth Drive shoe?  Yes  No  
Weight 27 lbs./ft. \_\_\_\_\_  
\_\_\_\_\_ in. to \_\_\_\_\_ ft. depth

| 2 | Type and color of material           | From | To  |
|---|--------------------------------------|------|-----|
|   | Gravel                               | 145  | 148 |
|   | Sandstone                            | 148  | 162 |
|   | Gravel                               | 162  | 164 |
|   | Clay                                 | 164  | 168 |
|   | Gravel                               | 168  | 174 |
|   | Clay                                 | 174  | 189 |
|   | Gravel                               | 189  | 197 |
|   | Sandstone                            | 197  | 218 |
|   | Gravel                               | 218  | 222 |
|   | sandstone                            | 222  | 226 |
|   | Gravel                               | 226  | 234 |
|   | Clay                                 | 234  | 258 |
|   | Sandstone                            | 258  | 260 |
|   | Gravel                               | 260  | 280 |
|   | Snapstone                            | 280  | 283 |
|   | (use a second sheet if needed) Shale | 283  |     |

8 Screen: Manufacturer W A. Brown  
Type Mill Sotl Dia. 16  
Slot/gauze 1/8 Length 2 1/2  
Set between 160 ft. and 283 ft.  
Fittings: Gravel pack  Yes  No Size range of material 1/2"  
9 Static water level: 153 ft. below land surface Date 1-11-75  
10 Pumping level below land surfaces:  
\_\_\_\_\_ ft. after \_\_\_\_\_ hrs. pumping \_\_\_\_\_ g.p.m.  
220 ft. after 8 hrs. pumping 1100 g.p.m.  
Estimated maximum yield 1100 g.p.m.

11 Water sample submitted:  Yes  No Date \_\_\_\_\_  
12 Well head completion:  Pitless adapter  Inches above grade  
13 Well grouted?  Yes  No  
 Neat cement  Bentonite  \_\_\_\_\_  
Depth: From \_\_\_\_\_ ft. to 10 ft.  
14 Nearest source of possible contamination:  
ft. \_\_\_\_\_ Direction \_\_\_\_\_ Type \_\_\_\_\_  
Well disinfected upon completion?  Yes  No

15 Pump:  Not installed  
Manufacturer's name Tait-Arc  
Model number \_\_\_\_\_ HP 125 Volts 460  
Length of drop pipe 270 ft. capacity 1100 g.m.p.  
Type:  Submersible  Turbine  
 Jet  Reciprocating  
 Centrifugal  Other

16 Remarks: elevation 3564 (Topo) 174 300  
Topography:  Hill  Slope  Upland  Valley

17 Water well contractor's certification:  
This well was drilled under my jurisdiction and this report is true to the best of my knowledge and belief.  
Foust Supply Co Inc 744  
Business name \_\_\_\_\_ License No. \_\_\_\_\_  
Address Box 338  
Signed Ralph Johnson Date 1-27-75  
Authorized representative