


1 LOCATION OF WATER WELL: Fraction NE 1/4 NE 1/4 NE 1/4 Section Number 28 Township Number T 8 S Range Number R 39 EW

Distance and direction from nearest town or city street address of well if located within city?
 1 Mile East, 1/2 Mile South, of Goodland

2 WATER WELL OWNER: Cecil Bowen
 RR#, St. Address, Box #: 2145 Road 64 Board of Agriculture, Division of Water Resources
 City, State, ZIP Code: Goodland, Ks. 67735 Application Number:

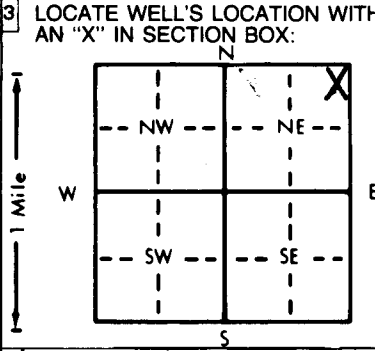

4 DEPTH OF COMPLETED WELL... 275 ft. ELEVATION:
 Depth(s) Groundwater Encountered 1. ft. 2. ft. 3. ft.
 WELL'S STATIC WATER LEVEL ... 176 ft. below land surface measured on mo/day/yr
 Pump test data: Well water was ft. after hours pumping gpm
 Est. Yield gpm: Well water was ft. after hours pumping gpm
 Bore Hole Diameter ... 8 in. to ... 275 ft., and ... in. to ... ft.
 WELL WATER TO BE USED AS: 5 Public water supply 8 Air conditioning 11 Injection well
 1 Domestic 3 Feedlot 6 Oil field water supply 9 Dewatering 12 Other (Specify below)
 2 Irrigation 4 Industrial 7 Lawn and garden only 10 Monitoring well
 Was a chemical/bacteriological sample submitted to Department? Yes.....No...X.....; If yes, mo/day/yr sample was submitted
 Water Well Disinfected? Yes X No

5 TYPE OF BLANK CASING USED: 5 Wrought iron 8 Concrete tile CASING JOINTS: Glued...X...Clamped...
 1 Steel 3 RMP (SR) 6 Asbestos-Cement 9 Other (specify below) Welded...
 2 PVC 4 ABS 7 Fiberglass Threaded...
 Blank casing diameter ... 4.5 in. to ... 235 ft., Dia ... in. to ... ft., Dia ... in. to ... ft.
 Casing height above land surface ... 18 in., weight ... 2.38 lbs./ft. Wall thickness or gauge No. ... 248
 TYPE OF SCREEN OR PERFORATION MATERIAL: 7 PVC 10 Asbestos-cement
 1 Steel 3 Stainless steel 5 Fiberglass 8 RMP (SR) 11 Other (specify) ...
 2 Brass 4 Galvanized steel 6 Concrete tile 9 ABS 12 None used (open hole)
 SCREEN OR PERFORATION OPENINGS ARE: 5 Gauzed wrapped 8 Saw cut 11 None (open hole)
 1 Continuous slot 3 Mill slot 6 Wire wrapped 9 Drilled holes
 2 Louvered shutter 4 Key punched 7 Torch cut 10 Other (specify) ...
 SCREEN-PERFORATED INTERVALS: From ... 235 ft. to ... 275 ft., From ... ft. to ... ft.
 GRAVEL PACK INTERVALS: From ... 20 ft. to ... 275 ft., From ... ft. to ... ft.

6 GROUT MATERIAL: 1 Neat cement 2 Cement grout 3 Bentonite 4 Other ...
 Grout Intervals: From ... 0 ft. to ... 20 ft., From ... ft. to ... ft., From ... ft. to ... ft.
 What is the nearest source of possible contamination: 10 Livestock pens 14 Abandoned water well
 1 Septic tank 4 Lateral lines 7 Pit privy 11 Fuel storage 15 Oil well/Gas well
 2 Sewer lines 5 Cess pool 8 Sewage lagoon 12 Fertilizer storage 16 Other (specify below)
 3 Watertight sewer lines 6 Seepage pit 9 Feedyard 13 Insecticide storage
 Direction from well? South How many feet? 300'

FROM	TO	LITHOLOGIC LOG	FROM	TO	PLUGGING INTERVALS
0	2	Surface	152	158	Med. Sand & Gravel
2	15	Loess	158	174	Sandy Clay w/Caliche
15	33	Clay	174	178	Med. Sand w/Clay Strks.
33	40	Sandy Clay Caliche & Sand Mix	178	185	Sandy Clay w/Caliche Strks.
40	57	Med. Sand & Gravel w/Rocks	185	197	Tight Med. Sand
57	70	Sandy Clay & Caliche	197	200	Sandy Clay
70	79	Med. Sand w/Clay & Caliche	200	204	Caliche w/Clay Strks.
79	85	Caliche w/Clay Strks.	204	213	Sandy Clay w/Caliche Strks.
85	100	Med. Sand & Gravel	213	214	Cemented Sand
100	111	Sandy Clay & Caliche w/Some Sand	214	222	Sandy Clay w/Caliche & Sand Strks
111	115	Caliche & Clay	222	228	Sandstone w/Sand & Clay Strks.
115	126	Med. Sand & Gravel w/Clay Strks.	228	231	Med. Sand
126	141	Sandy Clay & Caliche	231	235	Chirt w/Sand Strks.
141	142	Caliche	235	240	Sandstone, 240-244 Rock Layers
142	152	Sandy Clay w/Caliche w/Sand Strks.	244	256	Med. Sand & Gravel 256-264Clay
			264	275	Fine to Med. Sand & Gravel

7 CONTRACTOR'S OR LANDOWNER'S CERTIFICATION: This water well was (1) constructed, (2) reconstructed, or (3) plugged under my jurisdiction and was completed on (mo/day/year) ... 7-27-95 ... and this record is true to the best of my knowledge and belief. Kansas Water Well Contractor's License No. 554 ... This Water Well Record was completed on (mo/day/yr) ... 8-3-95 ... under the business name of Woofter Pump & Well, Inc. by (signature) *Jay L. Woofter*

INSTRUCTIONS: Use typewriter or ball point pen. PLEASE PRESS FIRMLY and PRINT clearly. Please fill in blanks, underline or circle the correct answers. Send top three copies to Kansas Department of Health and Environment, Bureau of Water, Topeka, Kansas 66620-0001. Telephone: 913-296-5545. Send one to WATER WELL OWNER and retain one for your records.